



City of Prince George
History Sheet

PID:	004443217
MU:	101739
WO:	90030

Civic Address: 6151 Gauthier Rd

Legal Description: Lot: 1 District Lot: 1571 Plan: 14923


Service Type	Diameter (mm)	Material	Invert Elev at main (m)	Invert Elev at property line (m)	Invert Elev at service end (m)	Distance into property (m)	Installation Date
Sanitary	100mm	PVC	-	-	-	-	January 1981
Water	100mm	PVC	-	-	-	-	Oct 2016
Storm	N/A	N/A	-	-	-	-	

Service Connection Location	Sanitary (m)	Storm (m)
100mm Sanitary forcemain service connected to San MH 4604	-	
Distance from downstream Stm MH - towards upstream Stm MH	-	

Power	Size	Communications	Size	Cable	Size	Gas	Size
BC Hydro	-	Telus	-	Shaw	-	FortisBC	-
Overhead Service		Overhead Service		Overhead Service			

Installed by:	City of Prince George forces	Survey Date:	-
Comments:			

NOT TO SCALE The information contained herein is for internal use only.
Not to be relied on unless confirmed by site inspection and/or investigation.

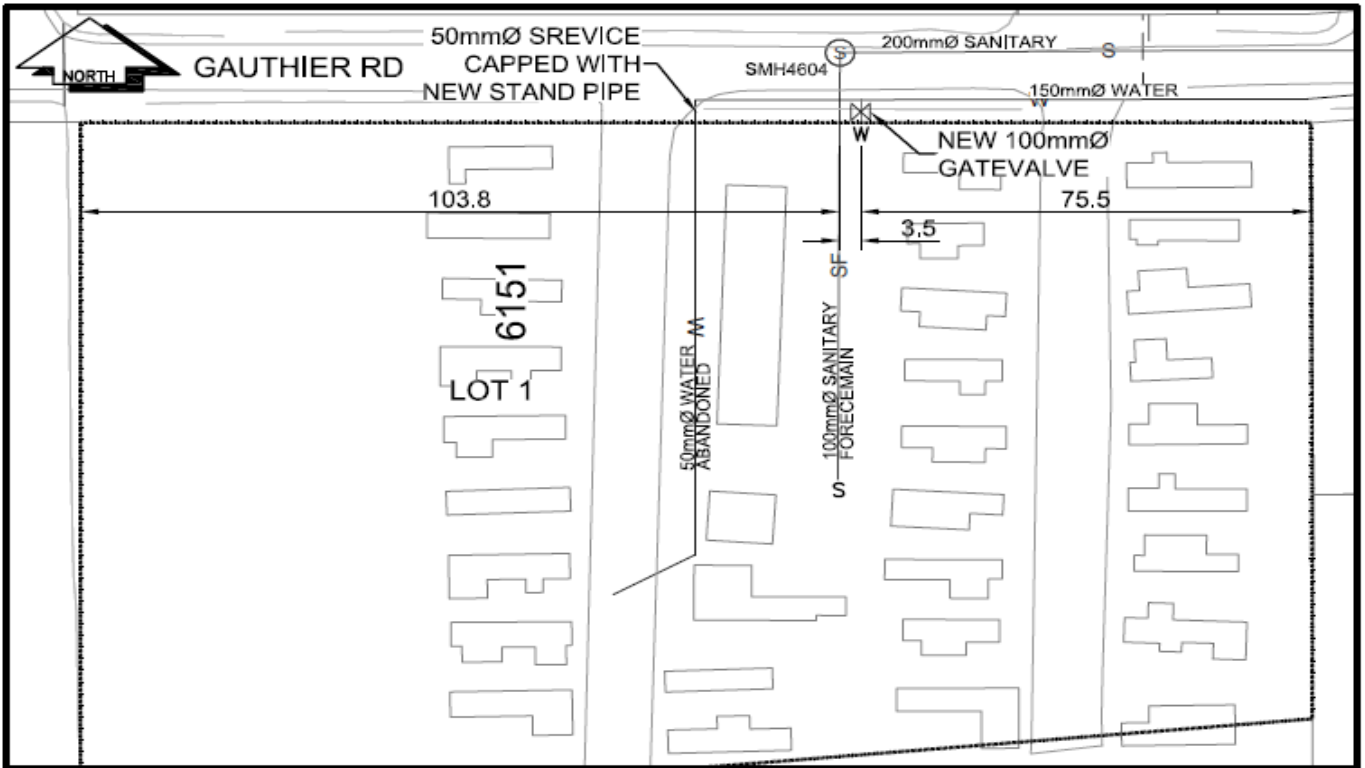

LEGEND:	
CS ^o CURB STOP	--- W WATER SERVICE
CO ^o CLEAN OUT	--- S SANITARY SERVICE
⊗ WATER VALVE	⊗ FIRE HYDRANT
	--- S STORM SERVICE
	--- G GAS
	--- ENCUMBRANCE

NOT TO SCALE