

**City of Prince George
HISTORY SHEET**

355
891

JJ

1974 SFG

SHEET NUMBER **8167** Roll Number **253**

Legal: LOT'S **9-10-11** BLOCK **14** D.L. **933** PLAN **727**

Address: **2633 Third Street ISLANDER ST**

Sanitary Connection: # SIZE **4"** MATERIAL **AC** INV. CONNECTED **1971**

Water Connection # SIZE **3/4"** MATERIAL **CV** METER CONNECTED **yes**

Storm Connection: # SIZE MATERIAL INV. CONNECTED

Cash Receipt No's: WATER **pd.** SANITARY **pd.** STORM

CURB FROM PROPERTY LINE PAVEMENT WIDTH

B.C. HYDRO **0H** UNDERGROUND CONNECTION


B.C. TELEPHONE **0H** UNDERGROUND CONNECTION

INLAND GAS

Information Sheets: **THE INFORMATION CONTAINED HEREIN IS FOR INTERNAL USE ONLY. NOT TO BE RELIED UPON UNLESS CONFIRMED BY SITE INSPECTION AND/OR INVESTIGATION.**

Comments:


SITE PLAN N.T.S.

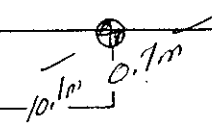

Sanitar



Water

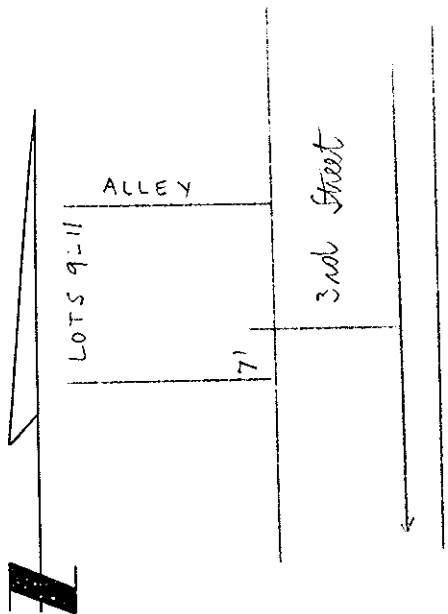

NOT TO BE USED FOR CONSTRUCTION

