

City of Prince George  
HISTORY SHEET

SHEET NUMBER [REDACTED] Roll Number 004463111

Legal: LOT'S *REAR N.E. 1/4* BLOCK D.L. *1599* PLAN

Address: *EUGENE RD.* (*E. VAN DORE*)

Sanitary Connection: # SIZE MATERIAL INV. CONNECTED

Water Connection # *11875* SIZE *3/4"* MATERIAL *CU* METER CONNECTED

Storm Connection: # SIZE MATERIAL INV. CONNECTED

Cash Receipt No's: WATER *1010* SANITARY STORM

CURB FROM PROPERTY LINE PAVEMENT WIDTH

B.C. HYDRO UNDERGROUND CONNECTION


B.C. TELEPHONE UNDERGROUND CONNECTION

INLAND GAS

Information Sheets:

Comments:

SITE PLAN N.T.S.

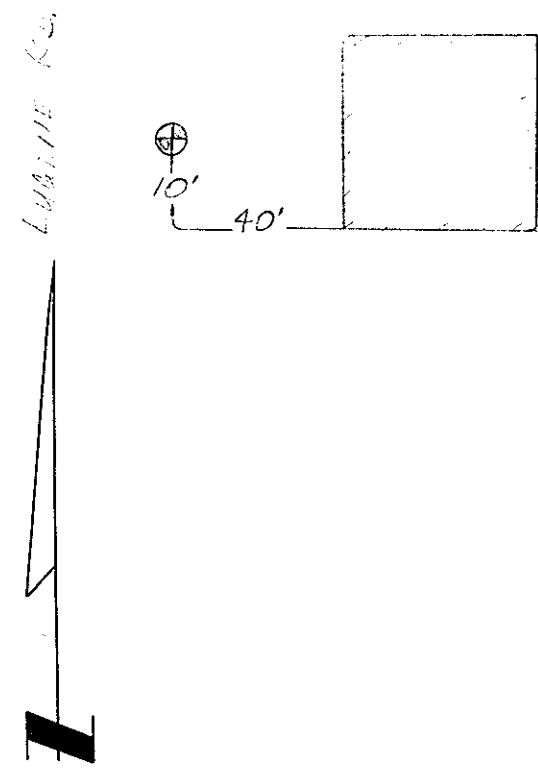

*See plan 3/18/98*