

City of Prince George HISTORY SHEET

SHEET NUMBER _____ Roll Number **PG5105**

Legal: LOT'S **P. 1 (28263)** BLOCK _____ D.L. **4047** PLAN **9543**

Address: **3858 AUSTIN ROAD WEST**

Sanitary Connection: # **15225** SIZE **100mm** MATERIAL _____ INV. **CONN. 1243-739.120** **CONNECTED**

Water Connection # **15225** SIZE **50mm** MATERIAL **COPPER** METER _____ **CONNECTED**

Storm Connection: # **1412** SIZE **150mm** MATERIAL _____ INV. _____ **CONNECTED**

Cash Receipt No's: WATER **12404 2158** SANITARY **12147 2241** STORM **12145 2013**

CURB FROM PROPERTY LINE _____ PAVEMENT WIDTH _____

B.C. HYDRO **O.H.** UNDERGROUND CONNECTION _____


B.C. TELEPHONE **O.H.** UNDERGROUND CONNECTION _____

INLAND GAS **AS SHOWN**

Information Sheets: **579 NIL**, **579 15' W**

Comments: **NID. WATER SERVICE - 8' EAST OF POWER POLE - IN SMALL BOX**

THE INFORMATION CONTAINED HEREIN IS FOR INTERNAL USE ONLY. NOT TO BE RELIED UPON UNLESS CONFIRMED BY SITE INSPECTION AND/OR INVESTIGATION.

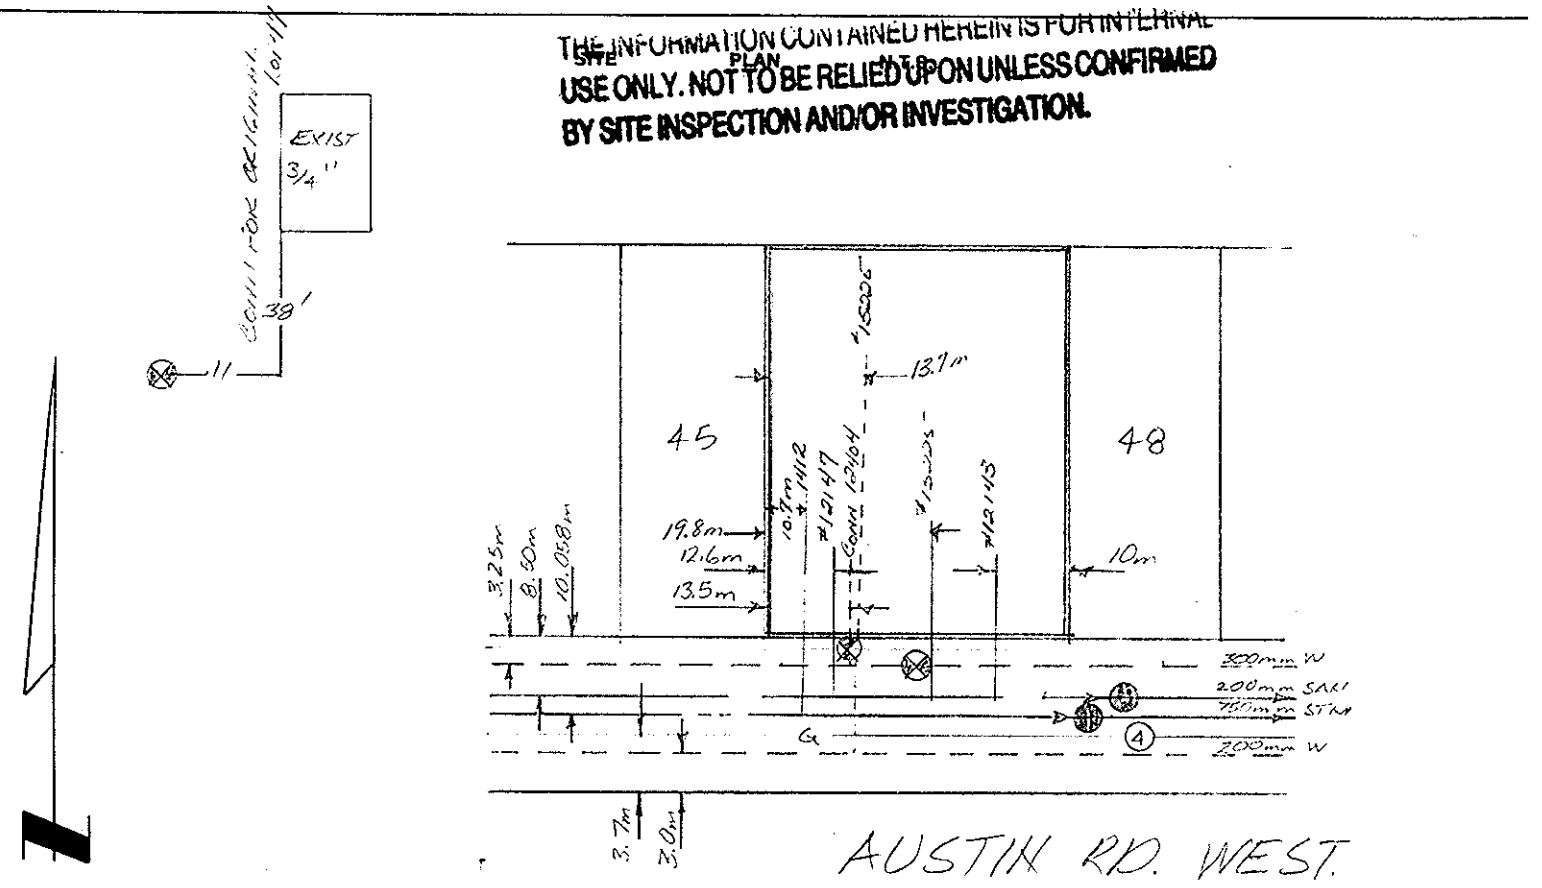

AUSTIN RD. WEST.