

City of Prince George HISTORY SHEET

SHEET NUMBER

Roll Number

PG5105

Legal: LOT'S *R. 1 (28362)* BLOCK

D.L. *4047*

PLAN *9543*

Address: *3858 AUSTIN ROAD WEST*

Sanitary Connection: # *15225* *12143* *12147* SIZE *100mm* *100mm* MATERIAL *CONN. 12143-759.120* INV. *CONN. 12147-757.412* **CONNECTED**

Water Connection # *15225* *12404* *1150* SIZE *50mm* *20mm* *3/4"* MATERIAL *COPPER* METER **CONNECTED**

Storm Connection: # *1412* SIZE *150mm* MATERIAL INV. **CONNECTED**

Cash Receipt No's: WATER *12409* *15225* *12143* *2159* *373* *224* *372* *213* SANITARY *12147* *15225* *12143* STORM *274*

CURB FROM PROPERTY LINE

PAVEMENT WIDTH

B.C. HYDRO *D.H.*

UNDERGROUND CONNECTION

B.C. TELEPHONE *D.H.*

UNDERGROUND CONNECTION


INLAND GAS *AS SHOWN*

Information Sheets:

579 NIL, 579 15'W

Comments: *NID. WATER SERVICE - 8' EAST OF POWER POLE - IN SMALL BOX*

**THE INFORMATION CONTAINED HEREIN IS FOR INTERNAL
SITE PLAN USE ONLY. NOT TO BE RELIED UPON UNLESS CONFIRMED
BY SITE INSPECTION AND/OR INVESTIGATION.**

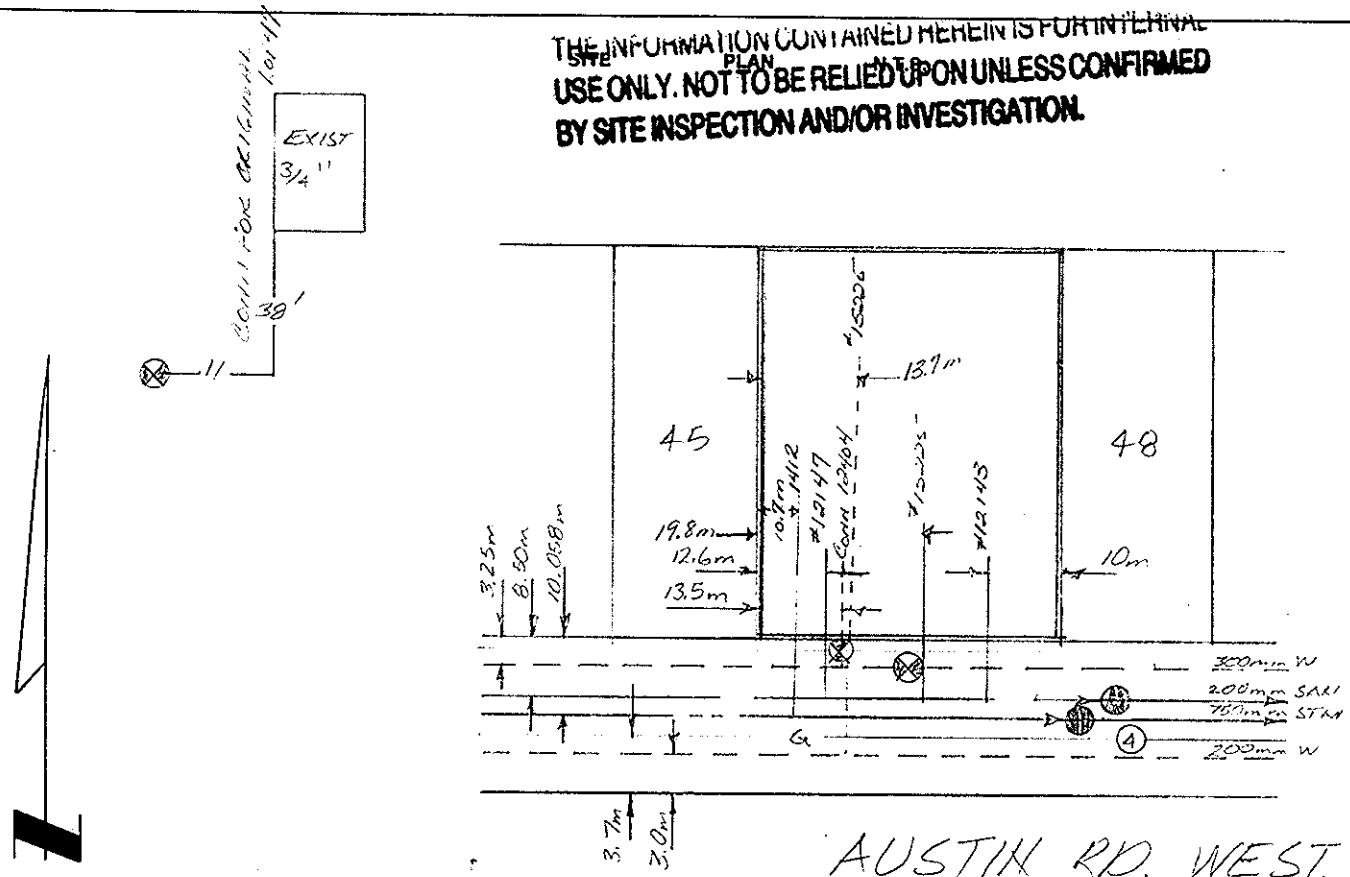

AUSTIN RD. WEST.