

City of Prince George HISTORY SHEET

SHEET NUMBER _____ Roll Number **PG5105**

Legal: LOT'S **R. 1 (28363)** BLOCK _____ D.L. **4047** PLAN **9543**

Address: **3858 AUSTIN ROAD WEST**

Sanitary Connection: # **15225** **12143** **12147** SIZE **100mm** to **100mm** MATERIAL _____ INV. **CONN. 12143-753.120** **12147-757.418** **CONNECTED**

Water Connection # **15225** **12404** **1150** EXISTING SIZE **25mm** to **3/4"** MATERIAL **COPPER** METER _____ **CONNECTED**

Storm Connection: # **1412** SIZE **150mm** MATERIAL _____ INV. _____ **CONNECTED**

Cash Receipt No's: WATER **12404** **19225** **2159** **373** SANITARY **12143** **15225** **2274** **372** **12143** **2213** STORM **274**

CURB FROM PROPERTY LINE _____ PAVEMENT WIDTH _____

B.C. HYDRO **O.H.** UNDERGROUND CONNECTION _____


B.C. TELEPHONE **O.H.** UNDERGROUND CONNECTION _____

INLAND GAS **AS SHOWN**

Information Sheets: **579 NIL**, **579 15'W**

Comments: **NID. WATER SERVICE - 8' EAST OF POWER PULL-IN SMALL BOX**

**THE INFORMATION CONTAINED HEREIN IS FOR INTERNAL
SITE PLAN USE ONLY. NOT TO BE RELIED UPON UNLESS CONFIRMED
BY SITE INSPECTION AND/OR INVESTIGATION.**

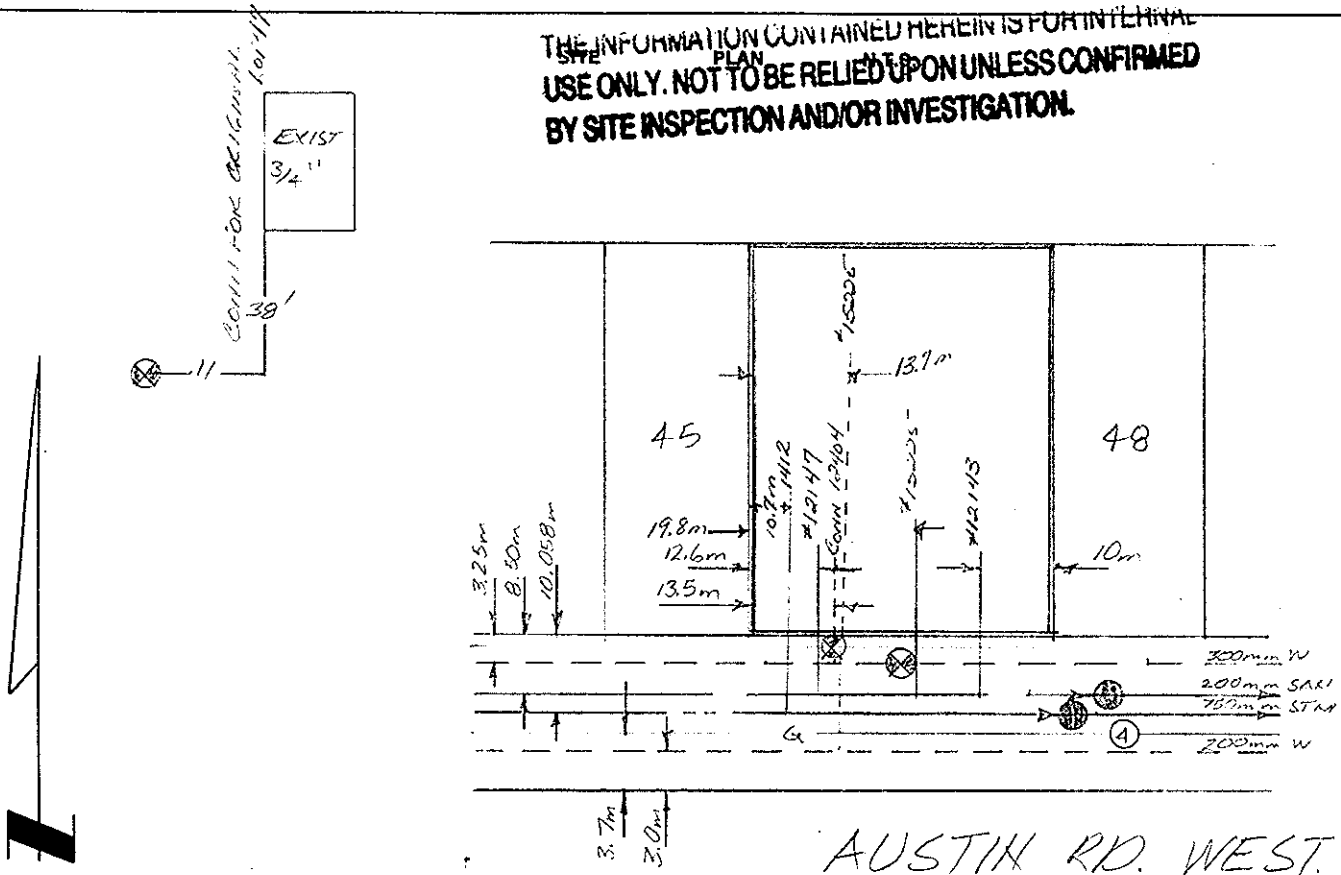

AUSTIN RD. WEST.