

# City of Prince George HISTORY SHEET

SHEET NUMBER

Roll Number **PG5105**

Legal: LOT'S **R. 1 (2826<sup>2</sup>)** BLOCK

D.L. **4047**

PLAN **2543**

Address: **3858 AUSTIN ROAD WEST**

Sanitary Connection: # **15225** SIZE **100mm** MATERIAL **100mm** CONV. 12143-759, 120 **CONNECTED**

Water Connection # **15225** SIZE **50mm** MATERIAL **COPPER** METER **CONNECTED**

Storm Connection: # **1412** SIZE **150mm** MATERIAL **CONNECTED**

Cash Receipt No's: WATER **12409** **15225** SANITARY **12143** **15225** **12143** STORM **274**

CURB FROM PROPERTY LINE

PAVEMENT WIDTH

B.C. HYDRO **O.H.**

UNDERGROUND CONNECTION

B.C. TELEPHONE **O.H.**

UNDERGROUND CONNECTION


INLAND GAS **AS SHOWN**

Information Sheets:

**579 NIL, 579 15' W**

Comments: **OLD LOT 44 N/D. WATER SERVICE - 8' EAST OF POWER PULL-IN SMALL BOX**

**THE INFORMATION CONTAINED HEREIN IS FOR INTERNAL USE ONLY. NOT TO BE RELIED UPON UNLESS CONFIRMED BY SITE INSPECTION AND/OR INVESTIGATION.**

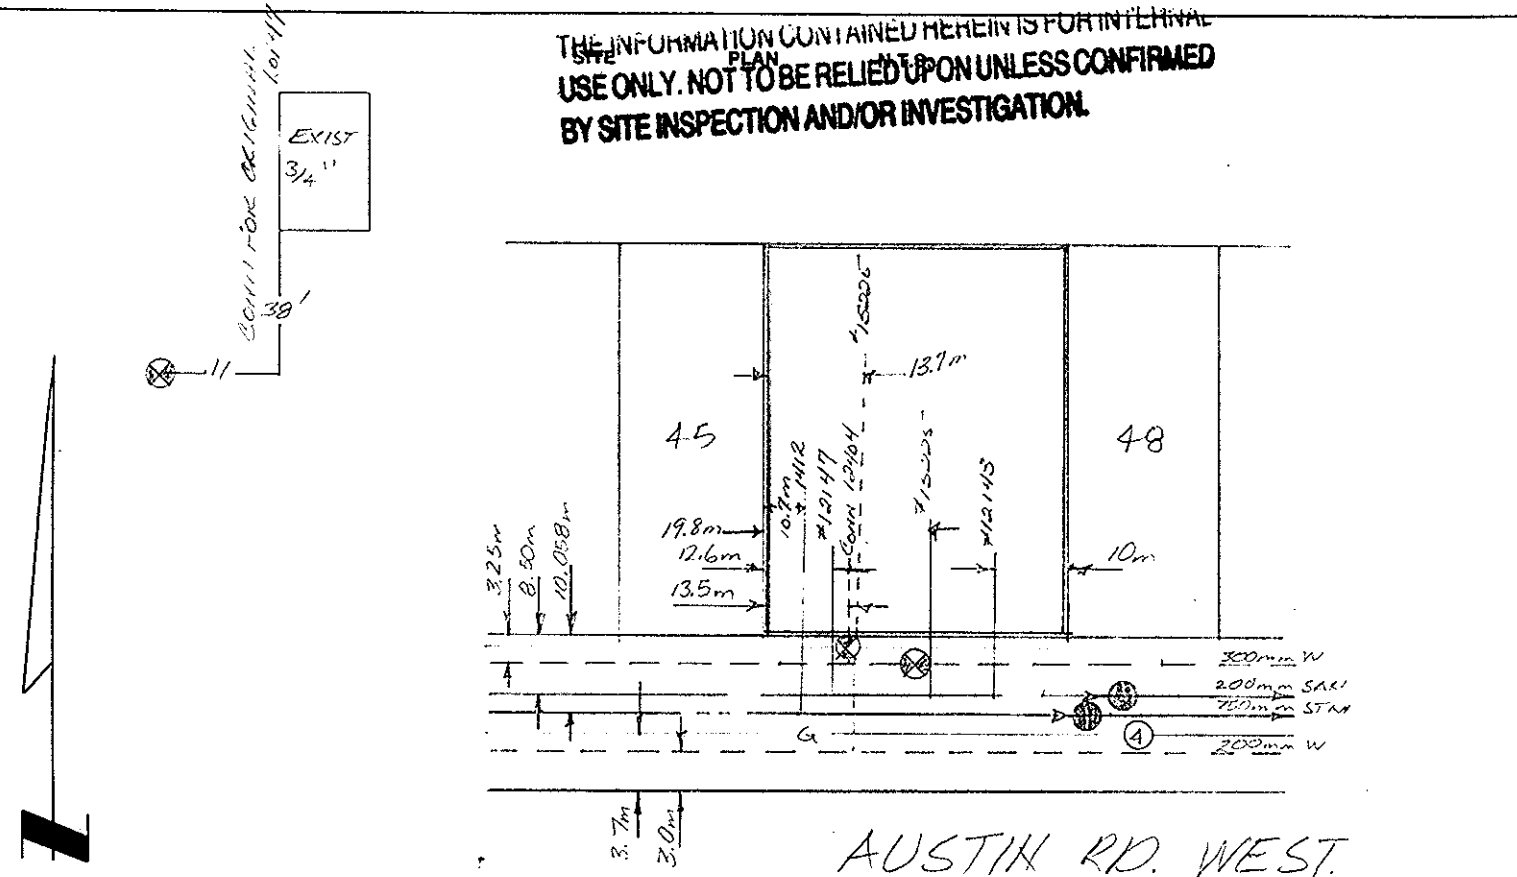

**AUSTIN RD. WEST.**