

City of Prince George HISTORY SHEET

SHEET NUMBER

Roll Number **PG5105**

Legal: LOT'S **R. 1 (28363)** BLOCK

D.L. **4047**

PLAN **9543**

Address: **3858 AUSTIN ROAD WEST**

Sanitary Connection: # **15225** **150mm** SIZE **100mm** MATERIAL **100mm** INV. **CONV. 1243-759.120** **12143** **12147** **CONNECTED**

Water Connection # **15225** **50mm** SIZE **20mm** MATERIAL **COPPER** METER **CONNECTED**

Storm Connection: # **1412** **150mm** SIZE MATERIAL INV. **CONNECTED**

Cash Receipt No's: WATER **12409** **15225** **12143** SANITARY **12147** **15225** **12143** STORM **374**

CURB FROM PROPERTY LINE

PAVEMENT WIDTH

B.C. HYDRO **D.H.** UNDERGROUND CONNECTION


B.C. TELEPHONE **D.H.** UNDERGROUND CONNECTION

INLAND GAS **AS SHOWN**

Information Sheets: **579 NIL**, **579 15' W**

Comments: **NID. WATER SERVICE - 8' EAST OF POWER PULL-IN SHALL BOX**

THE INFORMATION CONTAINED HEREIN IS FOR INTERNAL USE ONLY. NOT TO BE RELIED UPON UNLESS CONFIRMED BY SITE INSPECTION AND/OR INVESTIGATION.

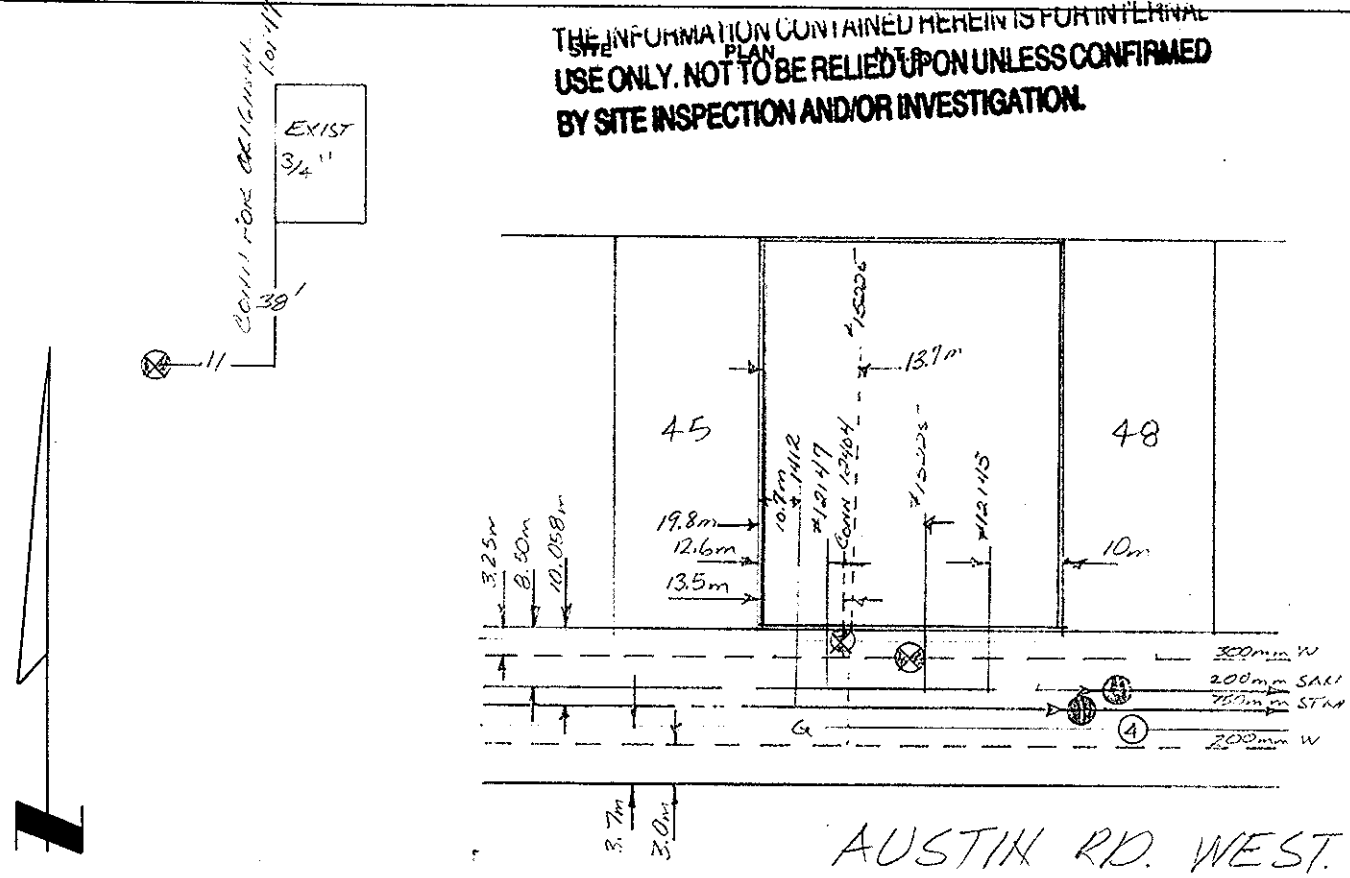

AUSTIN RD. WEST.