

# City of Prince George HISTORY SHEET

SHEET NUMBER

Roll Number **PG5105**

Legal: LOT'S **Pl. 1 (2836)** BLOCK

D.L. **4047**

PLAN **9543**

Address: **3858 AUSTIN ROAD WEST**

Sanitary Connection: # **15225** **150mm** SIZE **100mm** to **100mm** MATERIAL **1150** INV. **1243-739.120** **1247-757.118** **CONNECTED**

Water Connection # **15225** **50mm** SIZE **20mm** **3/4"** MATERIAL **COPPER** METER **CONNECTED**

Storm Connection: # **1412** SIZE **150mm** MATERIAL INV. **CONNECTED**

Cash Receipt No's: WATER **12409** **13285** **373** SANITARY **12147** **15225** **12143** **2274** **372** **2273** STORM **274**

CURB FROM PROPERTY LINE

PAVEMENT WIDTH

B.C. HYDRO **O.H.** UNDERGROUND CONNECTION


B.C. TELEPHONE **O.H.** UNDERGROUND CONNECTION

INLAND GAS **AS SHOWN**

Information Sheets: **579 NIL** , **579 15'W**

Comments: **NID. WATER SERVICE - 8' EAST OF POWER POLE - IN SMALL BOX**

**THE INFORMATION CONTAINED HEREIN IS FOR INTERNAL  
USE ONLY. NOT TO BE RELIED UPON UNLESS CONFIRMED  
BY SITE INSPECTION AND/OR INVESTIGATION.**

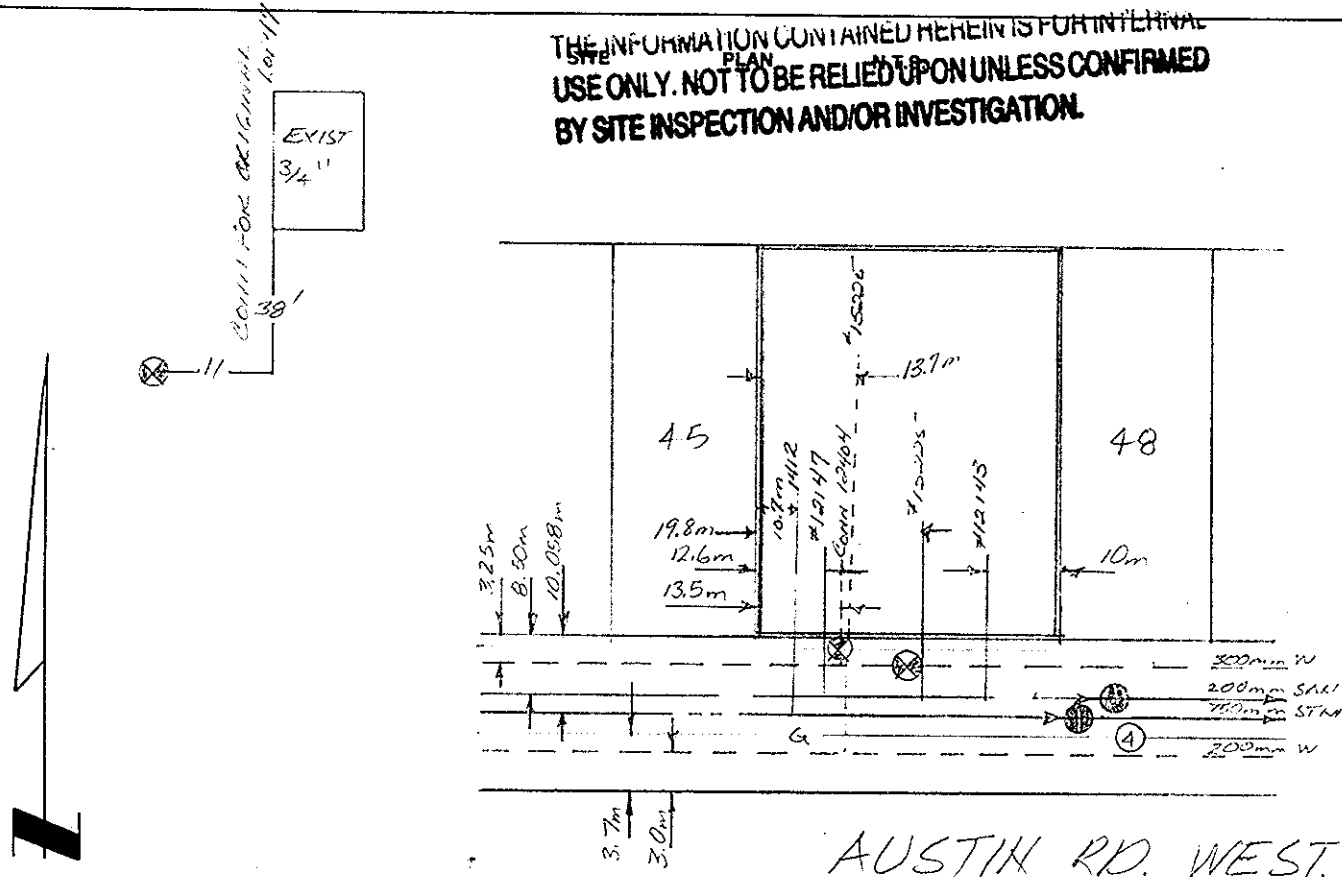

**AUSTIN RD. WEST.**