

# City of Prince George HISTORY SHEET

SHEET NUMBER

Roll Number **PG5105**

Legal: LOT'S **R1 1 (2856)** BLOCK D.L. **4047** PLAN **9543**

Address: **3858 AUSTIN ROAD WEST**

Sanitary Connection: # **15225** SIZE **100mm** MATERIAL **110mm** INV. **CONN. 1243-759.120** **CONNECTED**

Water Connection # **15225** SIZE **50mm** MATERIAL **COPPER** METER **CONNECTED**

Storm Connection: # **1412** SIZE **150mm** MATERIAL **INV.** **CONNECTED**

Cash Receipt No's: WATER **12909** **2159** **373** SANITARY **12147** **15225** **12143** **2274** **372** **2273** STORM **274**

CURB FROM PROPERTY LINE PAVEMENT WIDTH

B.C. HYDRO **O.H.** UNDERGROUND CONNECTION


B.C. TELEPHONE **O.H.** UNDERGROUND CONNECTION

INLAND GAS **AS SHOWN**

Information Sheets: **579 NIL, 579 15'W**

Comments: **OLD LOT 41**  
**NID. WATER SERVICE - 8' EAST OF POWER POLE - IN SMALL BOX**

**THE INFORMATION CONTAINED HEREIN IS FOR INTERNAL  
USE ONLY. NOT TO BE RELIED UPON UNLESS CONFIRMED  
BY SITE INSPECTION AND/OR INVESTIGATION.**

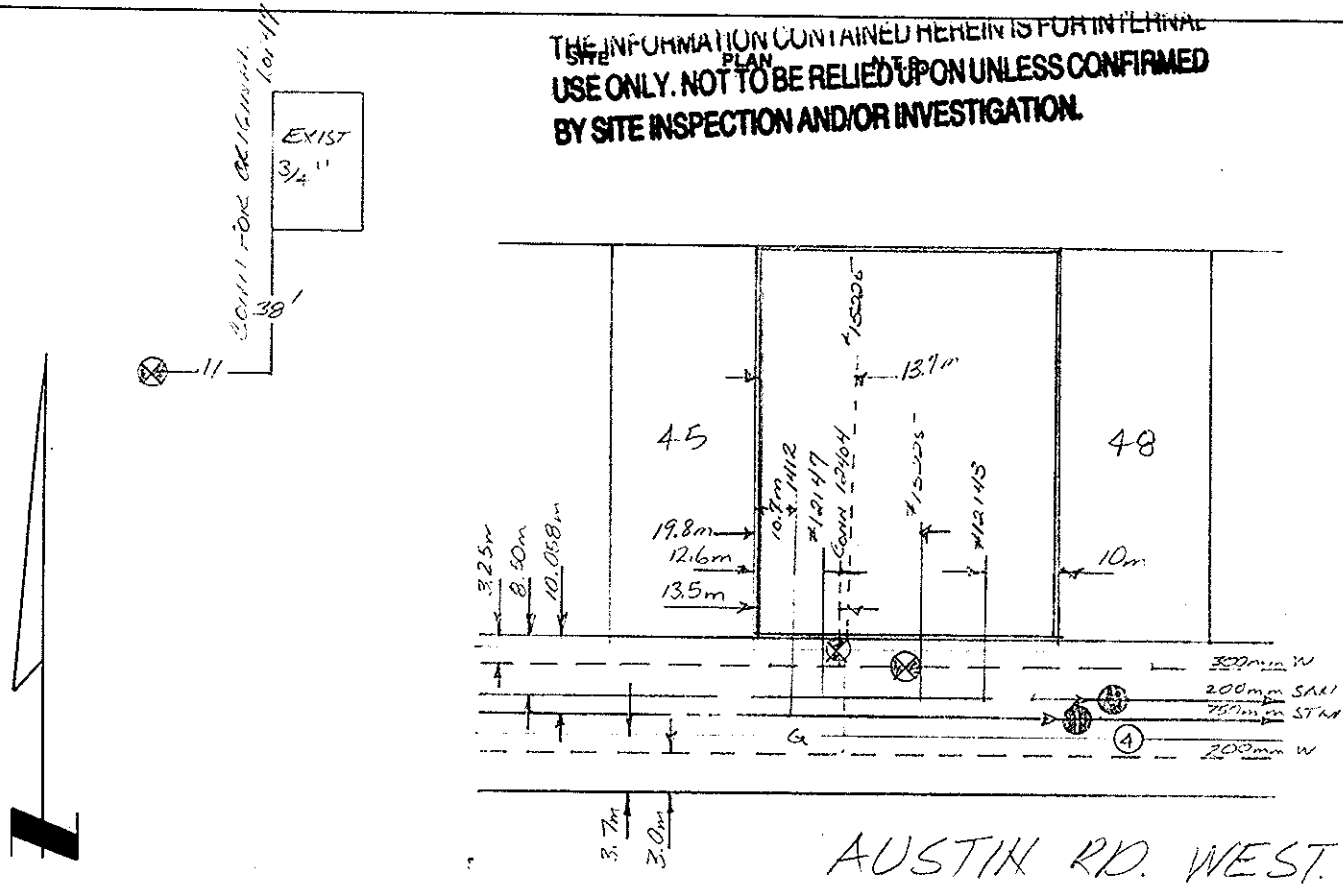

AUSTIN RD. WEST.