

# City of Prince George HISTORY SHEET

SHEET NUMBER

Roll Number **PG5105**

Legal: LOT'S **PL 1 (2826-2)** BLOCK

D.L. **4047**

PLAN **9543**

Address: **3858 AUSTIN ROAD WEST**

Sanitary Connection: # **15225** **150mm** SIZE **100mm** MATERIAL **100mm** INV. **CONN. 12143-759-120** **12143** **12147** **12148** **CONNECTED**

Water Connection # **15225** **50mm** SIZE **1150** MATERIAL **COPPER** METER **CONNECTED**  
**12404** **EXISTING** SIZE **20mm** **3/4"**

Storm Connection: # **1412** SIZE **150mm** MATERIAL INV. **CONNECTED**

Cash Receipt No's: WATER **12409** **15225** **12143** **15225** **12143**  
**2158** **373** **2274** **372** **2213** SANITARY STORM **274**

CURB FROM PROPERTY LINE PAVEMENT WIDTH

B.C. HYDRO **D.H.** UNDERGROUND CONNECTION


B.C. TELEPHONE **D.H.** UNDERGROUND CONNECTION

INLAND GAS **AS SHOWN**

Information Sheets: **579 NIL** **579 15' W**

Comments: **OLD LOT 11**  
**NIP. WATER SERVICE - 8' EAST OF POWER PULL-IN SMALL BOX**

THE INFORMATION CONTAINED HEREIN IS FOR INTERNAL  
 USE ONLY. NOT TO BE RELIED UPON UNLESS CONFIRMED  
 BY SITE INSPECTION AND/OR INVESTIGATION.

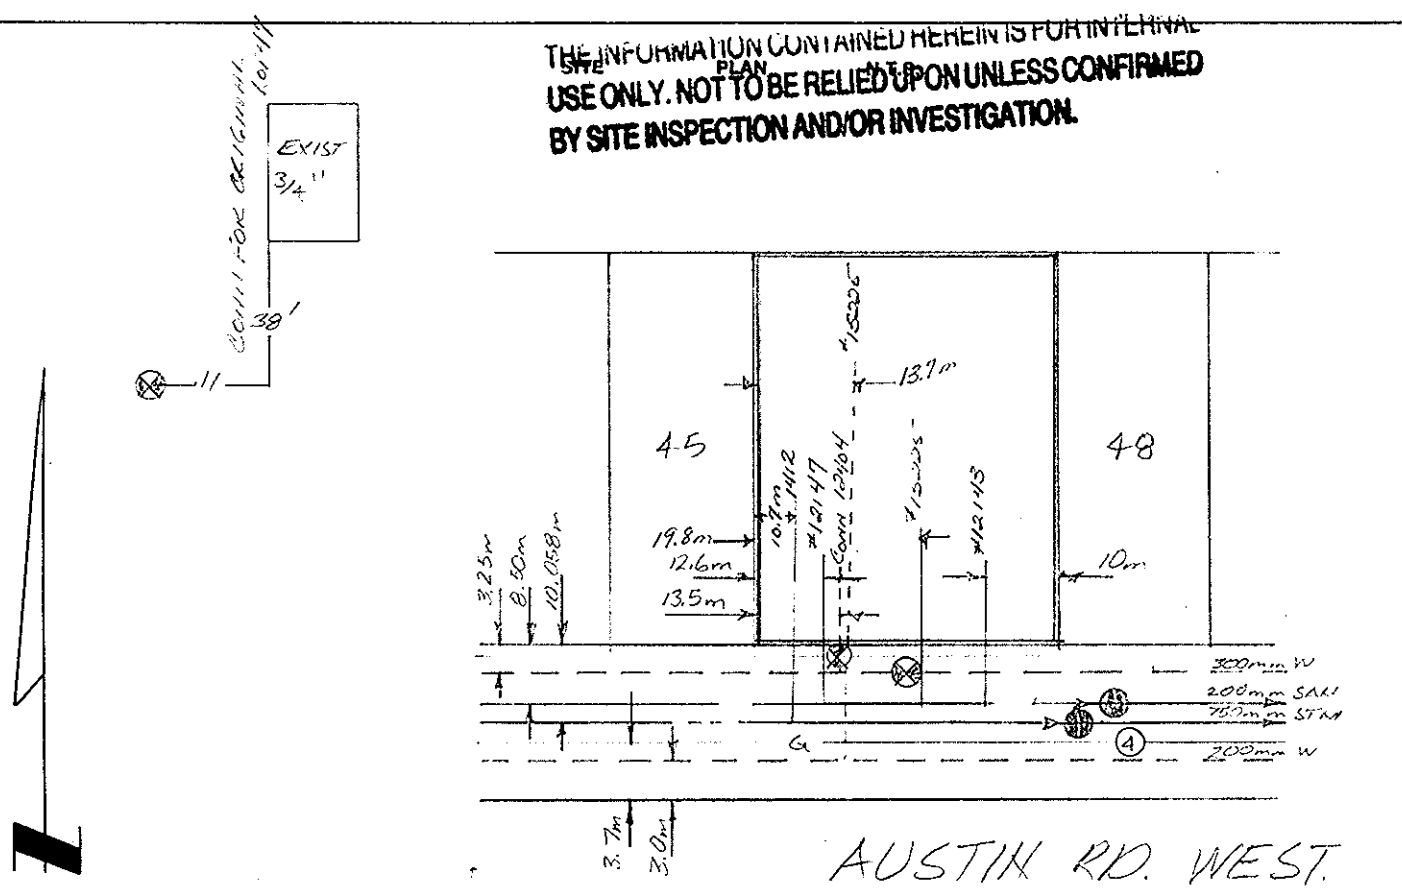

AUSTIN RD. WEST.