

# City of Prince George HISTORY SHEET

SHEET NUMBER

Roll Number

*PG5105*

Legal: LOT'S

*Pl. 1 (2836<sup>2</sup>)*

BLOCK

D.L.

*4047*

PLAN

*9543*

Address:

*3858 AUSTIN ROAD WEST*

Sanitary Connection: #

*15225 150m*

SIZE *100mm to 100mm* MATERIAL

CON. *1243-759, 120*  
INV. CON. *1247-757, 413* CONNECTED

Water Connection #

*15225 50m*

*12404 ALSO EXISTING SIZE 26mm 3/4"* MATERIAL *COPPER* METER

CONNECTED

Storm Connection: #

*1412* SIZE *150mm* MATERIAL

INV. CONNECTED

Cash Receipt No's:

WATER	<i>12404</i>	<i>15225</i>	SANITARY	<i>1243</i>	<i>15225</i>	<i>1243</i>	STORM	<i>374</i>
	<i>2158</i>	<i>373</i>		<i>2274</i>	<i>372</i>	<i>2273</i>		

CURB FROM PROPERTY LINE

PAVEMENT WIDTH

B.C. HYDRO

*D.H.*

UNDERGROUND CONNECTION

B.C. TELEPHONE

*D.H.*

UNDERGROUND CONNECTION

INLAND GAS

*AS SHOWN*

Information Sheets:


*CAD LOT 41*

*579 NIL, 579 15' W*

Comments:

*NID. WATER SERVICE - 8' EAST OF POWER PULL-IN SHALL BOX*

THE INFORMATION CONTAINED HEREIN IS FOR INTERNAL  
USE ONLY. NOT TO BE RELIED UPON UNLESS CONFIRMED  
BY SITE INSPECTION AND/OR INVESTIGATION.

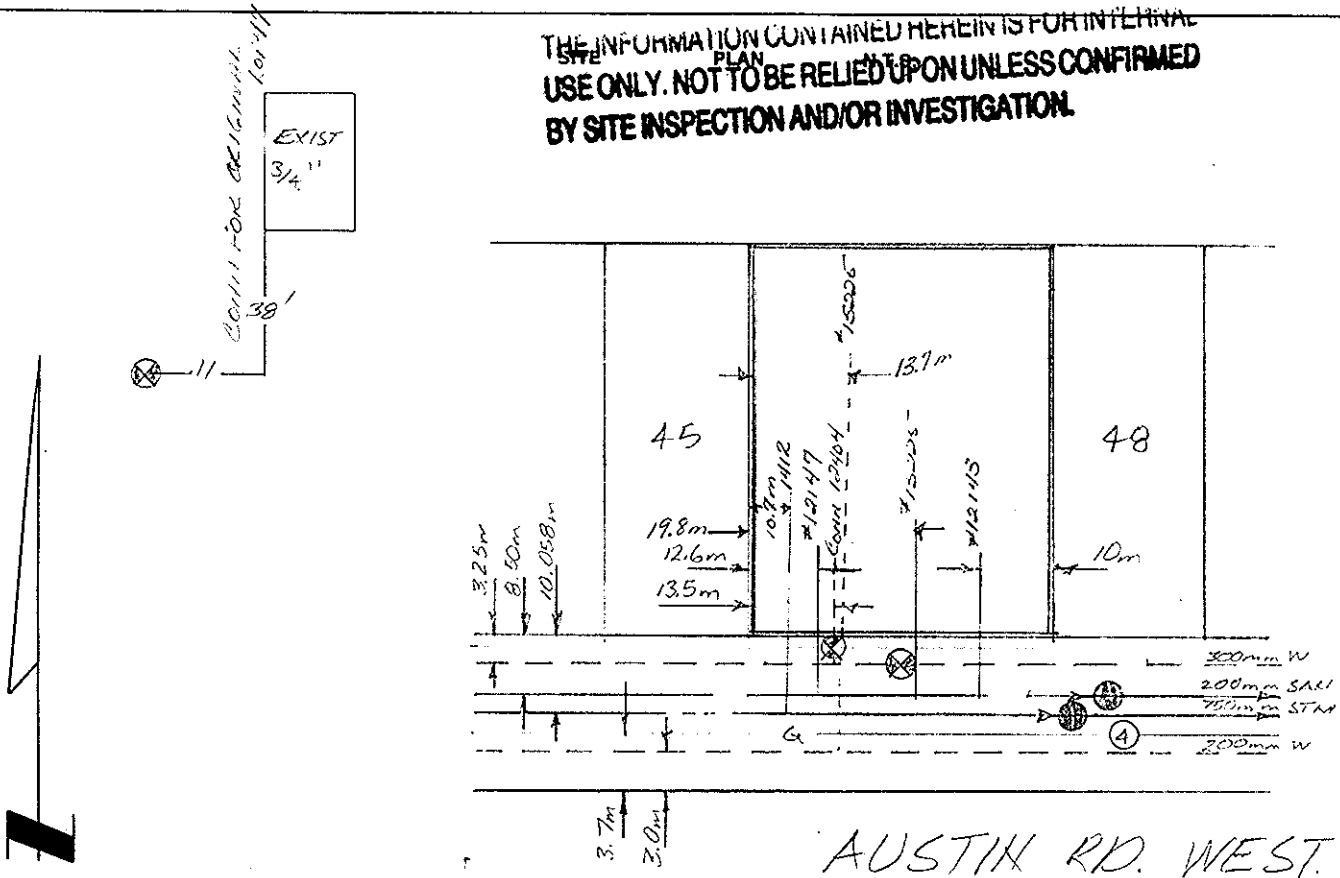

*AUSTIN RD. WEST.*