

# City of Prince George HISTORY SHEET

SHEET NUMBER

Roll Number

*PGS105*

Legal: LOT'S

*Pl 1 (28262)*

BLOCK

D.L.

*4047*

PLAN

*9543*

Address:

*3858 AUSTIN ROAD WEST*

Sanitary Connection: #

*15225 150m n*

*12143 12147* SIZE *100mm* MATERIAL

CONV. *1243-759.120*  
INV. CONV. *1247-757.418* CONNECTED

Water Connection #

*15225 50m n*

*12404* ALSO EXISTING SIZE *20mm* MATERIAL *COPPER* METER

CONNECTED

Storm Connection: #

*1412* SIZE *150mm* MATERIAL

INV. CONNECTED

Cash Receipt No's:

WATER	<i>12409</i>	<i>15225</i>	SANITARY	<i>12143</i>	<i>15225</i>	<i>12143</i>	STORM	<i>274</i>
	<i>2159</i>	<i>373</i>		<i>2274</i>	<i>372</i>	<i>2213</i>		

CURB FROM PROPERTY LINE

PAVEMENT WIDTH

B.C. HYDRO

*D.H.*

UNDERGROUND CONNECTION

B.C. TELEPHONE

*D.H.*

UNDERGROUND CONNECTION

INLAND GAS

*AS SHOWN*


Information Sheets:

*579 NIL, 579 15' W*

Comments:

*OLD LOT 11  
MID. WATER SERVICE - 8' EAST OF POWER PULL-IN SMALL ROW*

THE INFORMATION CONTAINED HEREIN IS FOR INTERNAL  
USE ONLY. NOT TO BE RELIED UPON UNLESS CONFIRMED  
BY SITE INSPECTION AND/OR INVESTIGATION.

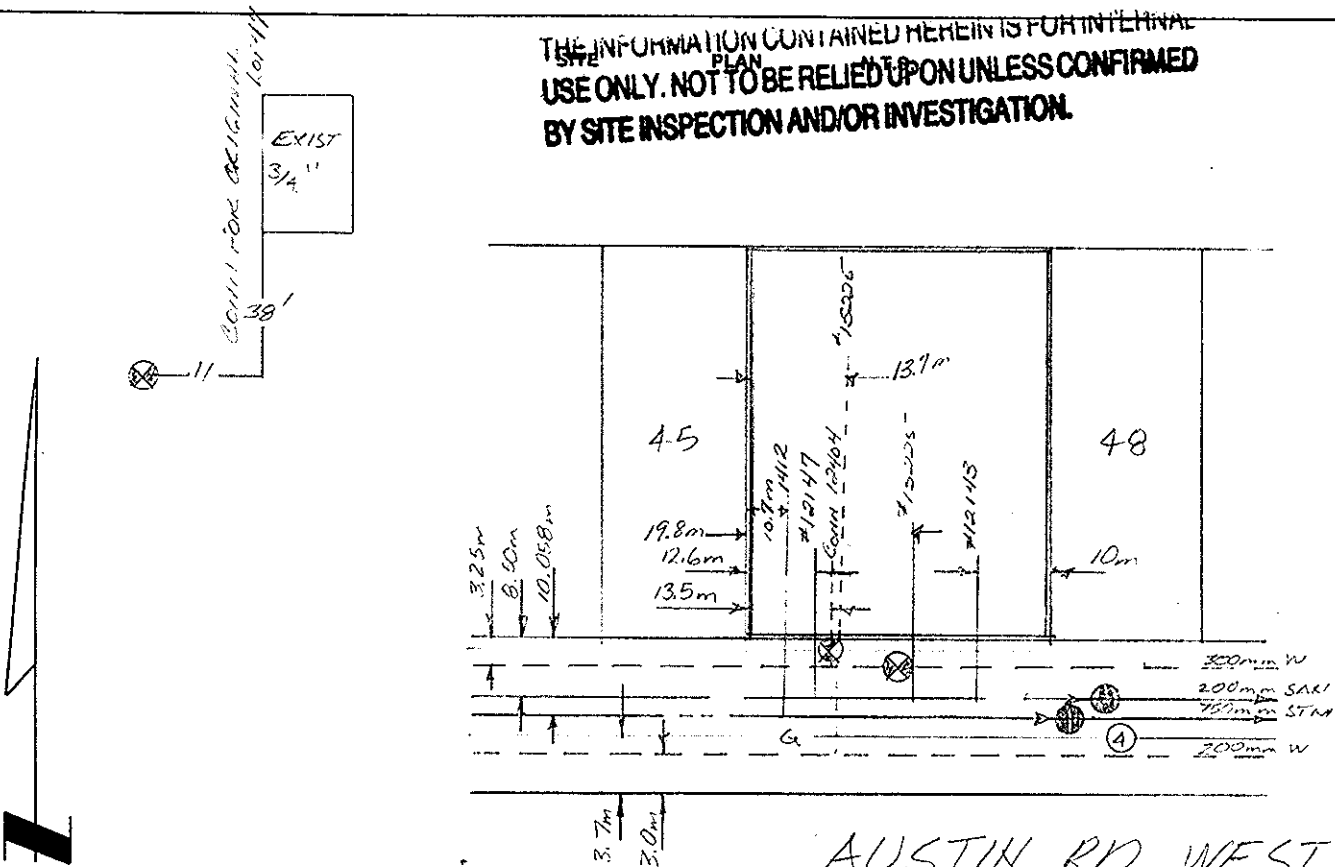

AUSTIN RD. WEST.