

City of Prince George HISTORY SHEET

SHEET NUMBER

Roll Number

PG5105

Legal: LOT'S

Pl 1 (2836)

BLOCK

D.L.

4047

PLAN

2543

Address:

3858 AUSTIN ROAD WEST

Sanitary Connection: #

15225 150mm

SIZE *100mm* MATERIAL

CON: 1243-759,120
INV. CONN: 1247-757,418 **CONNECTED**

Water Connection #

15225 50mm

12404 ALSO EXISTING SIZE 20mm 3/4" MATERIAL *COPPER* METER

CONNECTED

Storm Connection: #

1412 SIZE 150mm

MATERIAL

INV.

CONNECTED

Cash Receipt No's:

| | | | | | | | | |
|-------|--------------|--------------|----------|--------------|--------------|--------------|-------|------------|
| WATER | <i>12409</i> | <i>15225</i> | SANITARY | <i>12147</i> | <i>15225</i> | <i>12143</i> | STORM | <i>274</i> |
| | <i>2159</i> | <i>373</i> | | <i>2274</i> | <i>372</i> | <i>2213</i> | | |

CURB FROM PROPERTY LINE

PAVEMENT WIDTH

B.C. HYDRO

D.H.

UNDERGROUND CONNECTION

B.C. TELEPHONE

D.H.

UNDERGROUND CONNECTION

INLAND GAS

AS SHOWN


Information Sheets:

579 NIL, 579 15' W

Comments:

NO. WATER SERVICE - 8' EAST OF POWER POLE - IN SMALL BOX

THE INFORMATION CONTAINED HEREIN IS FOR INTERNAL
SITE USE ONLY. NOT TO BE RELIED UPON UNLESS CONFIRMED
BY SITE INSPECTION AND/OR INVESTIGATION.

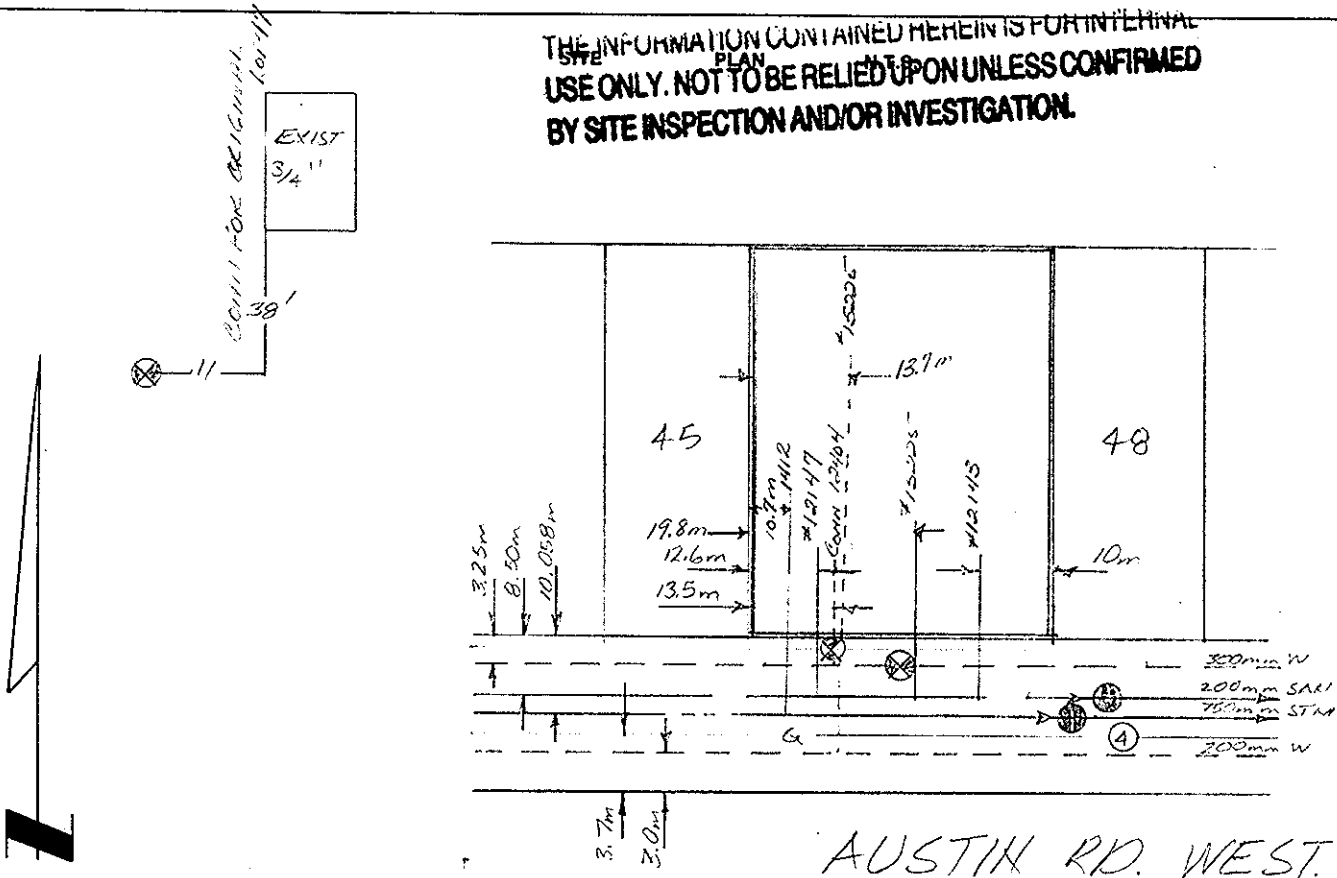

AUSTIN RD. WEST.