

City of Prince George HISTORY SHEET

SHEET NUMBER

Roll Number

PG5105

Legal: LOT'S

Pl. 1 (2826)

BLOCK

D.L.

4047

PLAN

954.5

Address:

3858 AUSTIN ROAD WEST

Sanitary Connection: #

15225 150mm

SIZE *100mm 100mm* MATERIAL

CONN. *12143-753,120*
INV. CONN. *12147-757,1418* CONNECTED

Water Connection #

15225 50mm

SIZE *20mm 3/4"* MATERIAL *COPPER* METER

CONNECTED

Storm Connection: #

1412 150mm

SIZE *150mm* MATERIAL

INV. CONNECTED

Cash Receipt No's:

WATER	<i>12409</i>	<i>15225</i>	SANITARY	<i>12143</i>	<i>15225</i>	<i>12143</i>	STORM	<i>274</i>
	<i>2154</i>	<i>373</i>		<i>2274</i>	<i>372</i>	<i>2213</i>		

CURB FROM PROPERTY LINE

PAVEMENT WIDTH

B.C. HYDRO

O.H.

UNDERGROUND CONNECTION

B.C. TELEPHONE

O.H.

UNDERGROUND CONNECTION

INLAND GAS

AS SHOWN


Information Sheets:

579 NIL 579 15' W

Comments:

*CAD LOC 11
MID. WATER SERVICE - 8' EAST OF POWER POLE - IN SMALL BOX*

THE INFORMATION CONTAINED HEREIN IS FOR INTERNAL
USE ONLY. NOT TO BE RELIED UPON UNLESS CONFIRMED
BY SITE INSPECTION AND/OR INVESTIGATION.

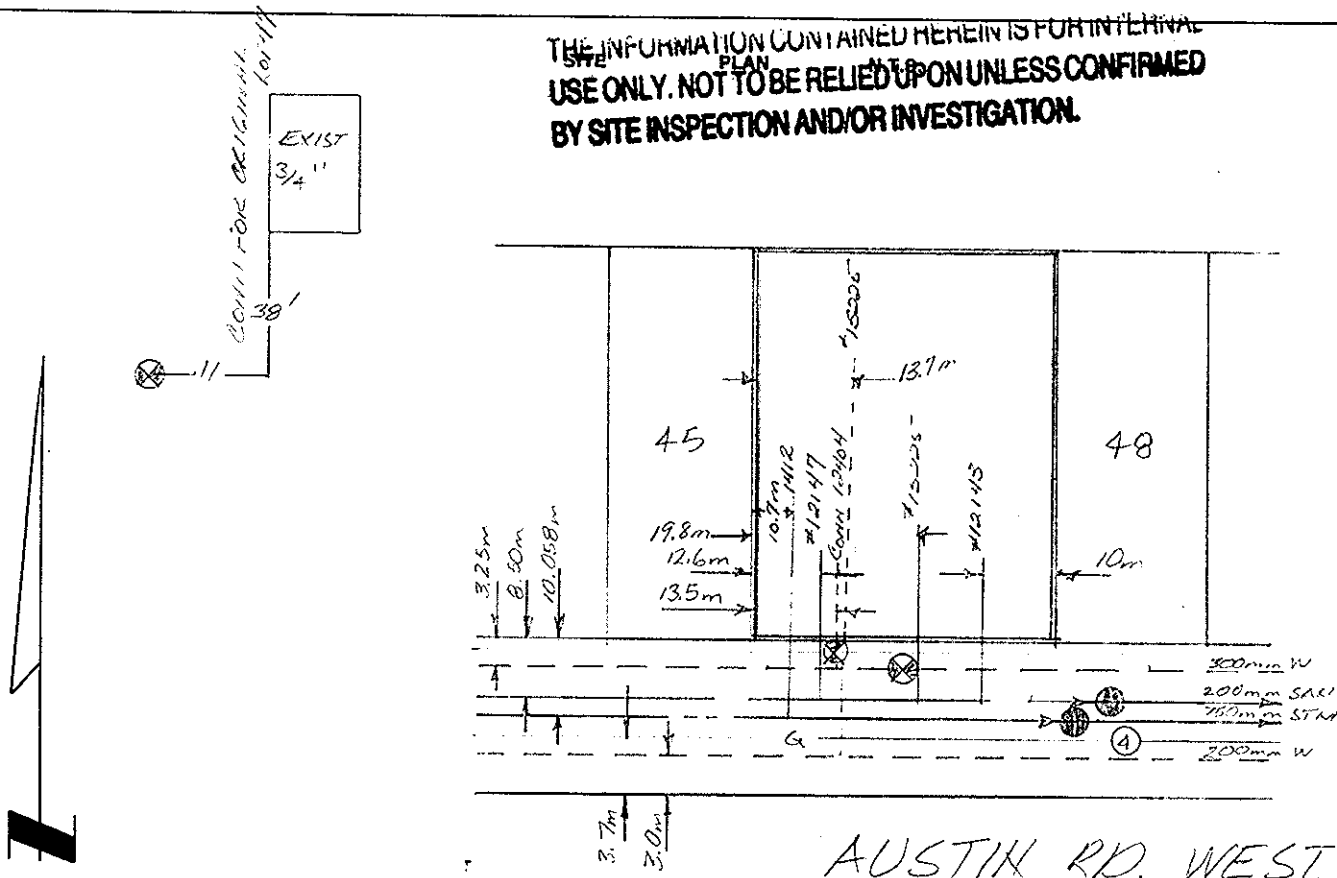

AUSTIN RD. WEST.