

City of Prince George HISTORY SHEET

SHEET NUMBER

Roll Number

PG5105

Legal: LOT'S *REL 1 15225* BLOCK

D.L. *4047*

PLAN *9543*

Address: *3858 AUSTIN ROAD WEST*

Sanitary Connection: # *15225* SIZE *100mm* MATERIAL *1100mm* INV. *CONJ. 1241-759.120* *1247-757.018* CONNECTED

Water Connection # *15225* SIZE *20mm* MATERIAL *COPPER* METER CONNECTED

Storm Connection: # *1412* SIZE *150mm* MATERIAL INV. CONNECTED

Cash Receipt No's: WATER *12409 2158 373* SANITARY *12103 15225 2271 372 2213* STORM *274*

CURB FROM PROPERTY LINE

PAVEMENT WIDTH

B.C. HYDRO *O.H.*

UNDERGROUND CONNECTION

B.C. TELEPHONE *O.H.*

UNDERGROUND CONNECTION


INLAND GAS *AS SHOWN*

Information Sheets:

579 NIL 579 15' W

Comments: *OLD LOT 11 MID. WATER SERVICE - 8' EAST OF POWER PULL-IN SMALL BOX*

THE INFORMATION CONTAINED HEREIN IS FOR INTERNAL
USE ONLY. NOT TO BE RELIED UPON UNLESS CONFIRMED
BY SITE INSPECTION AND/OR INVESTIGATION.

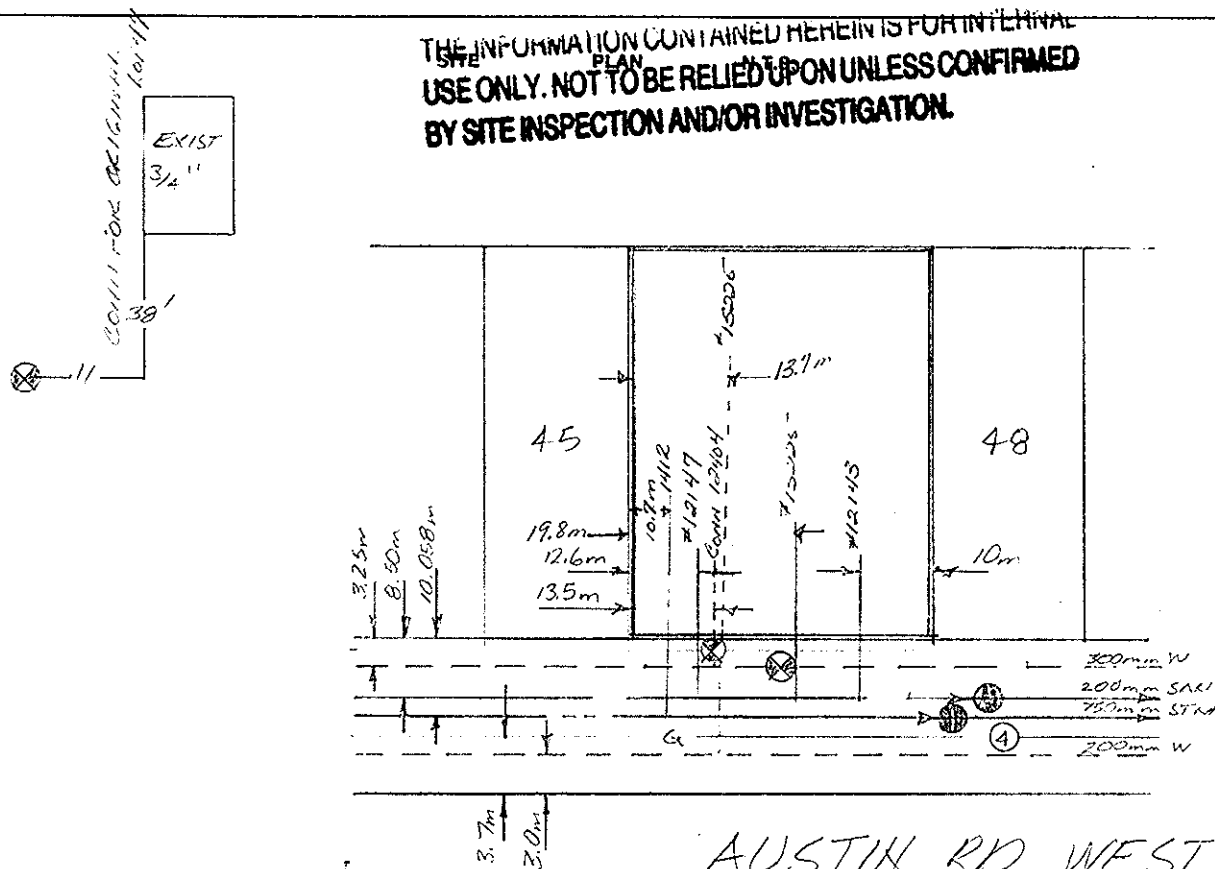

AUSTIN RD. WEST.