

# City of Prince George HISTORY SHEET

SHEET NUMBER \_\_\_\_\_ Roll Number **PG5105**

Legal: LOT'S **Pl. 1 (28<sup>263</sup>)** BLOCK \_\_\_\_\_ D.L. **4047** PLAN **9543**

Address: **3858 AUSTIN ROAD WEST**

Sanitary Connection: # **15225** SIZE **100mm** MATERIAL \_\_\_\_\_ INV. **CONV. 1243-739.120** **CONNECTED**

Water Connection # **15225** SIZE **50mm** MATERIAL \_\_\_\_\_ METER \_\_\_\_\_ **CONNECTED**

Storm Connection: # **12404** SIZE **200mm** MATERIAL **COPPER** METER \_\_\_\_\_ **CONNECTED**

Cash Receipt No's: WATER **12409 2154** SANITARY **12147 2241** STORM **12143 2013**

CURB FROM PROPERTY LINE \_\_\_\_\_ PAVEMENT WIDTH \_\_\_\_\_

B.C. HYDRO **D.H.** UNDERGROUND CONNECTION \_\_\_\_\_


B.C. TELEPHONE **D.H.** UNDERGROUND CONNECTION \_\_\_\_\_

INLAND GAS **AS SHOWN**

Information Sheets: **579 NIL**, **579 15' W**

Comments: **OLD LOT 44**  
**NID. WATER SERVICE - 8' EAST OF POWER PULL-IN SMALL BIN**

**THE INFORMATION CONTAINED HEREIN IS FOR INTERNAL  
SITE PLAN USE ONLY. NOT TO BE RELIED UPON UNLESS CONFIRMED  
BY SITE INSPECTION AND/OR INVESTIGATION.**

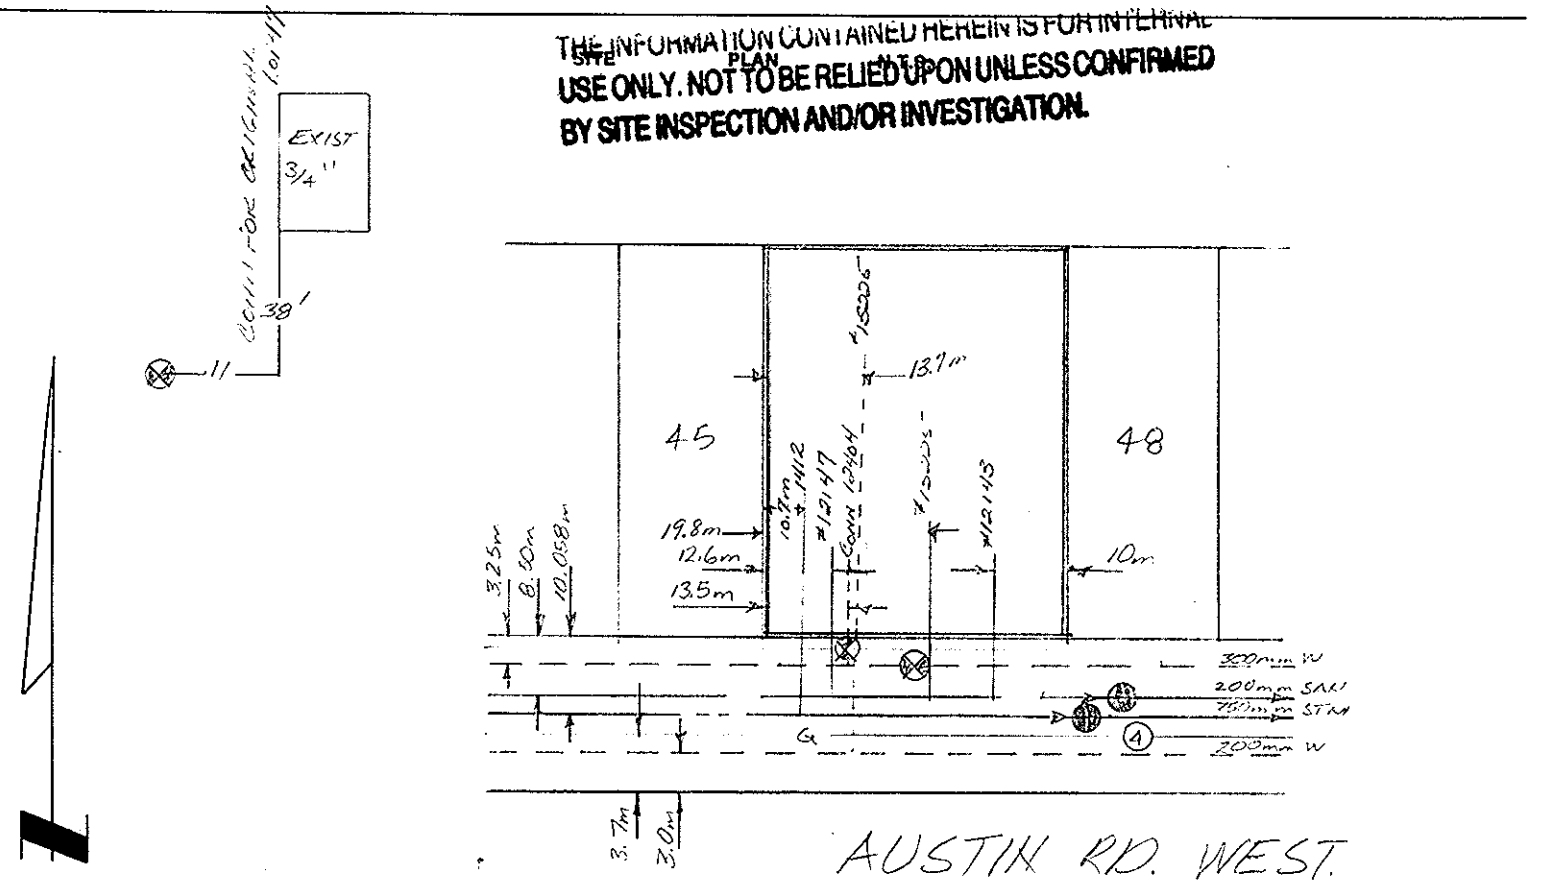

AUSTIN RD. WEST.