

# City of Prince George HISTORY SHEET

SHEET NUMBER \_\_\_\_\_ Roll Number **PGS105**

Legal: LOT'S **R. 1 (28363)** BLOCK \_\_\_\_\_ D.L. **4047** PLAN **9543**

Address: **3858 AUSTIN ROAD WEST**

Sanitary Connection: # **15225** SIZE **100mm** MATERIAL **100mm** CONN. 17M3-739.126 **CONNECTED**  
12143 12147

Water Connection # **15225** SIZE **50mm** MATERIAL **COPPER** METER **CONNECTED**  
12404 1150 EXISTING SIZE 20mm 3/4"

Storm Connection: # **1412** SIZE **150mm** MATERIAL \_\_\_\_\_ INV. **CONNECTED**

Cash Receipt No's: WATER **12409 15225** SANITARY **12143 15225** STORM **12143**  
259 373 274 372 273

CURB FROM PROPERTY LINE \_\_\_\_\_ PAVEMENT WIDTH \_\_\_\_\_

B.C. HYDRO **D.H.** UNDERGROUND CONNECTION \_\_\_\_\_


B.C. TELEPHONE **D.H.** UNDERGROUND CONNECTION \_\_\_\_\_

INLAND GAS **AS SHOWN**

Information Sheets: **579 NIL, 579 15' W**

Comments: **NID. WATER SERVICE - 8' EAST OF POWER PILE - IN SMALL BOX**

**THE INFORMATION CONTAINED HEREIN IS FOR INTERNAL USE ONLY. NOT TO BE RELIED UPON UNLESS CONFIRMED BY SITE INSPECTION AND/OR INVESTIGATION.**

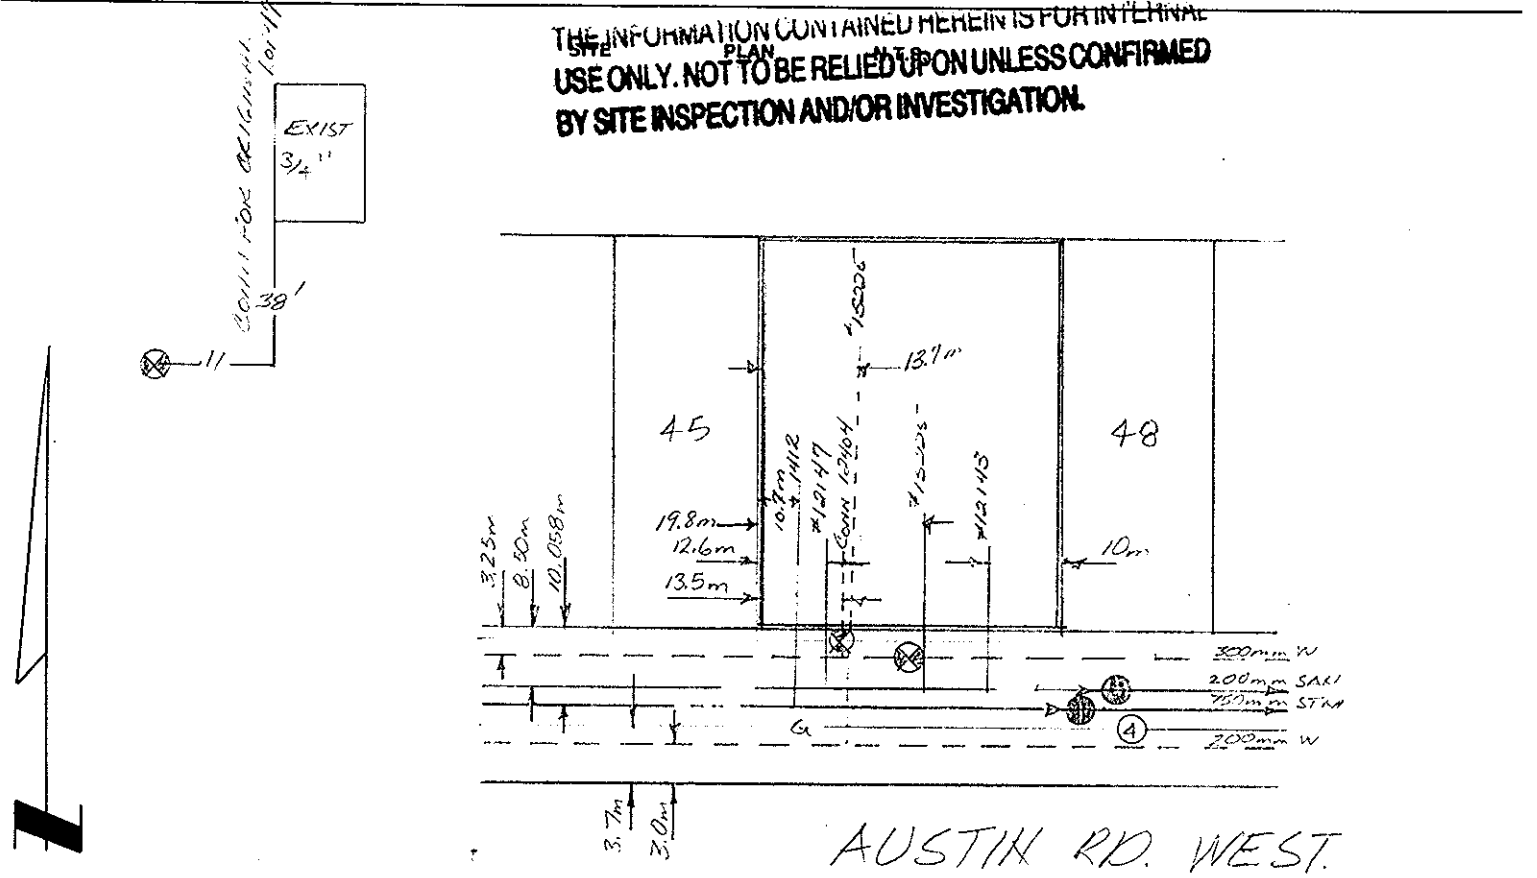

AUSTIN RD. WEST.