

City of Prince George HISTORY SHEET

SHEET NUMBER _____ Roll Number **PG5105**

Legal: LOT'S **R. 1 (2826²)** BLOCK _____ D.L. **4047** PLAN **9543**

Address: **3858 AUSTIN ROAD WEST**

Sanitary Connection: # **15225** SIZE **100mm** MATERIAL _____ INV. **12143-12147** **CONNECTED**

Water Connection # **15225** SIZE **20mm** MATERIAL **COPPER** METER _____ **CONNECTED**

Storm Connection: # **1412** SIZE **150mm** MATERIAL _____ INV. _____ **CONNECTED**

Cash Receipt No's: WATER **12909** **15225** **373** SANITARY **12147** **15225** **12143** **2274** **372** **2273** STORM **274**

CURB FROM PROPERTY LINE _____ PAVEMENT WIDTH _____

B.C. HYDRO **D.H.** UNDERGROUND CONNECTION _____


B.C. TELEPHONE **D.H.** UNDERGROUND CONNECTION _____

INLAND GAS **AS SHOWN**

Information Sheets: **579 NIL** **579 15' W**

Comments: **NID. WATER SERVICE - 8' EAST OF POWER POLE - IN SMALL BOX**

THE INFORMATION CONTAINED HEREIN IS FOR INTERNAL USE ONLY. NOT TO BE RELIED UPON UNLESS CONFIRMED BY SITE INSPECTION AND/OR INVESTIGATION.

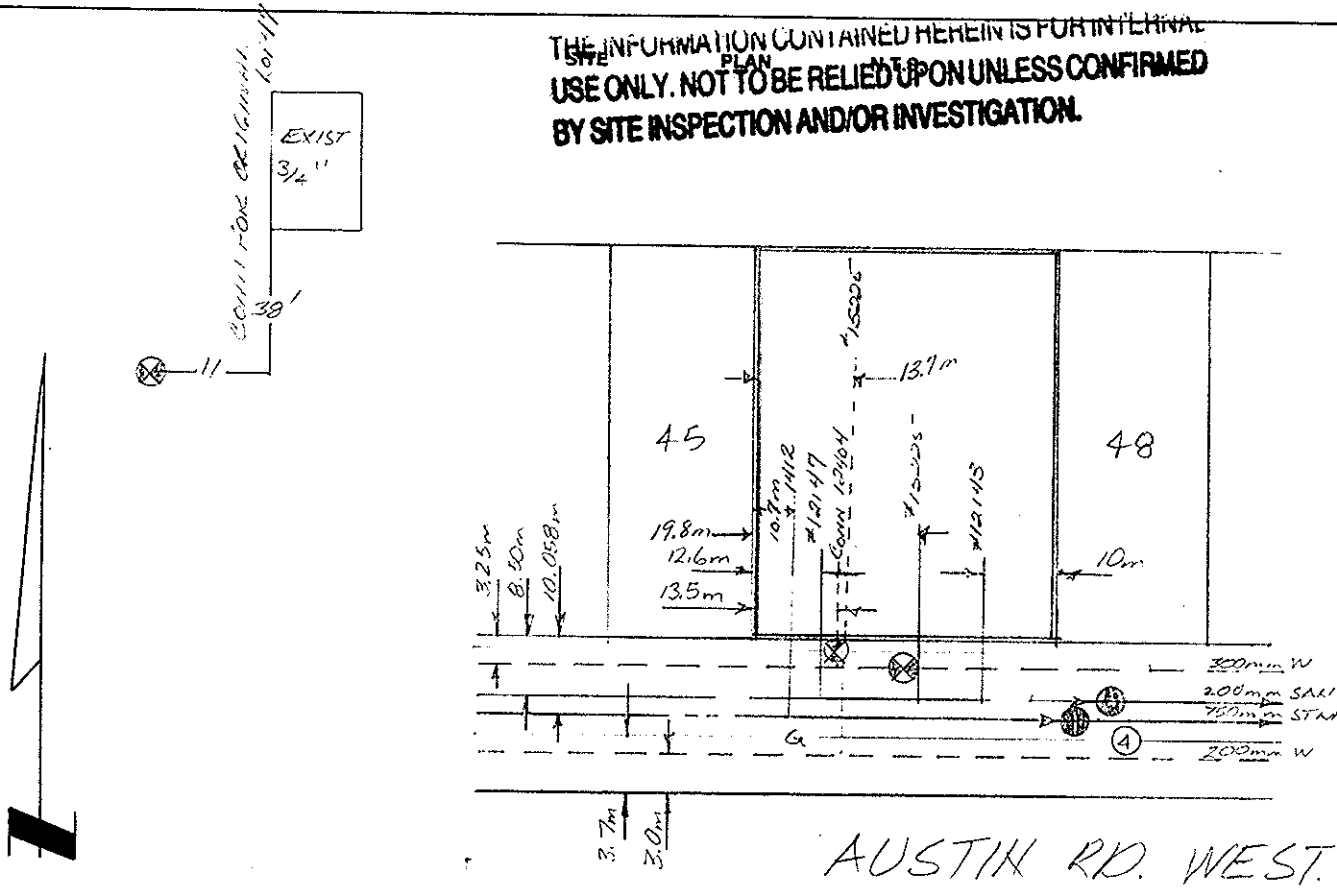

AUSTIN RD. WEST.