

City of Prince George HISTORY SHEET

SHEET NUMBER

Roll Number **PG5105**

Legal: LOT'S **P. 1 (28363)** BLOCK D.L. **4047** PLAN **9543**

Address: **3858 AUSTIN ROAD WEST**

Sanitary Connection: # **15225** **12143 12147** SIZE **100mm 100mm** MATERIAL **1150** INV. **CONN. 1243-739.120** **1247-737.418** **CONNECTED**

Water Connection # **15225** **12404** SIZE **20mm 3/4"** MATERIAL **COPPER** METER **CONNECTED**

Storm Connection: # **1412** SIZE **150mm** MATERIAL **CONNECTED**

Cash Receipt No's: WATER **12409 15225** SANITARY **12143 15225** STORM **12143**
2154 373 2274 372 2213 274

CURB FROM PROPERTY LINE PAVEMENT WIDTH

B.C. HYDRO **O.H.** UNDERGROUND CONNECTION


B.C. TELEPHONE **O.H.** UNDERGROUND CONNECTION

INLAND GAS **AS SHOWN**

Information Sheets: **579 NIL 579 15' W**

Comments: **CID LOT 11**
NID. WATER SERVICE - 8' EAST OF POWER POLE - IN SMALL BOX

THE INFORMATION CONTAINED HEREIN IS FOR INTERNAL
 USE ONLY. NOT TO BE RELIED UPON UNLESS CONFIRMED
 BY SITE INSPECTION AND/OR INVESTIGATION.

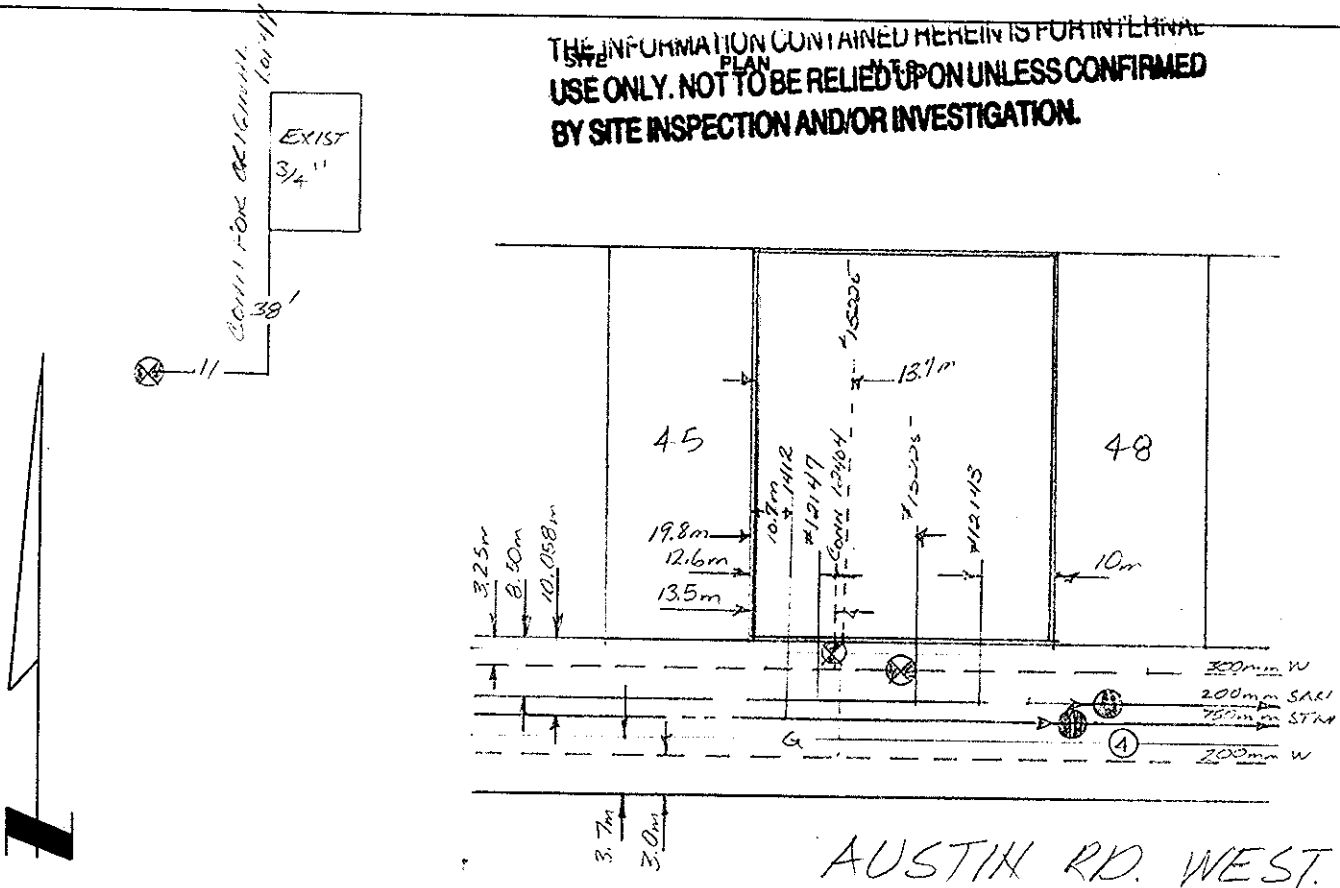

AUSTIN RD. WEST.