

City of Prince George

HISTORY SHEET

SHEET NUMBER _____ Roll Number **PGS105**

Legal: LOT'S **P.L. 1 (28263)** BLOCK _____ D.L. **4047** PLAN **9543**

Address: **3858 AUSTIN ROAD WEST**

Sanitary Connection: # **15225** **12143 12147** SIZE **100mm 100mm** MATERIAL _____ INV. **CONV. 12143-759.120** **CONV. 12147-757.113** **CONNECTED**

Water Connection # **15225** **12144** SIZE **50mm** MATERIAL **COPPER** METER _____ **CONNECTED**

Storm Connection: # **1412** SIZE **150mm** MATERIAL _____ INV. _____ **CONNECTED**

Cash Receipt No's: WATER **12409 15225** SANITARY **12143 15225** STORM **12143**

WATER	2159	373	SANITARY	2279	372	2213	STORM	274
-------	------	-----	----------	------	-----	------	-------	-----

CURB FROM PROPERTY LINE _____ PAVEMENT WIDTH _____

B.C. HYDRO **O.H.** UNDERGROUND CONNECTION _____


B.C. TELEPHONE **O.H.** UNDERGROUND CONNECTION _____

INLAND GAS **AS SHOWN**

Information Sheets: **579 NIL 579 15'W**

Comments: **N/D. WATER SERVICE - 8' EAST OF POWER POLE - IN SMALL BOX**

THE INFORMATION CONTAINED HEREIN IS FOR INTERNAL USE ONLY. NOT TO BE RELIED UPON UNLESS CONFIRMED BY SITE INSPECTION AND/OR INVESTIGATION.

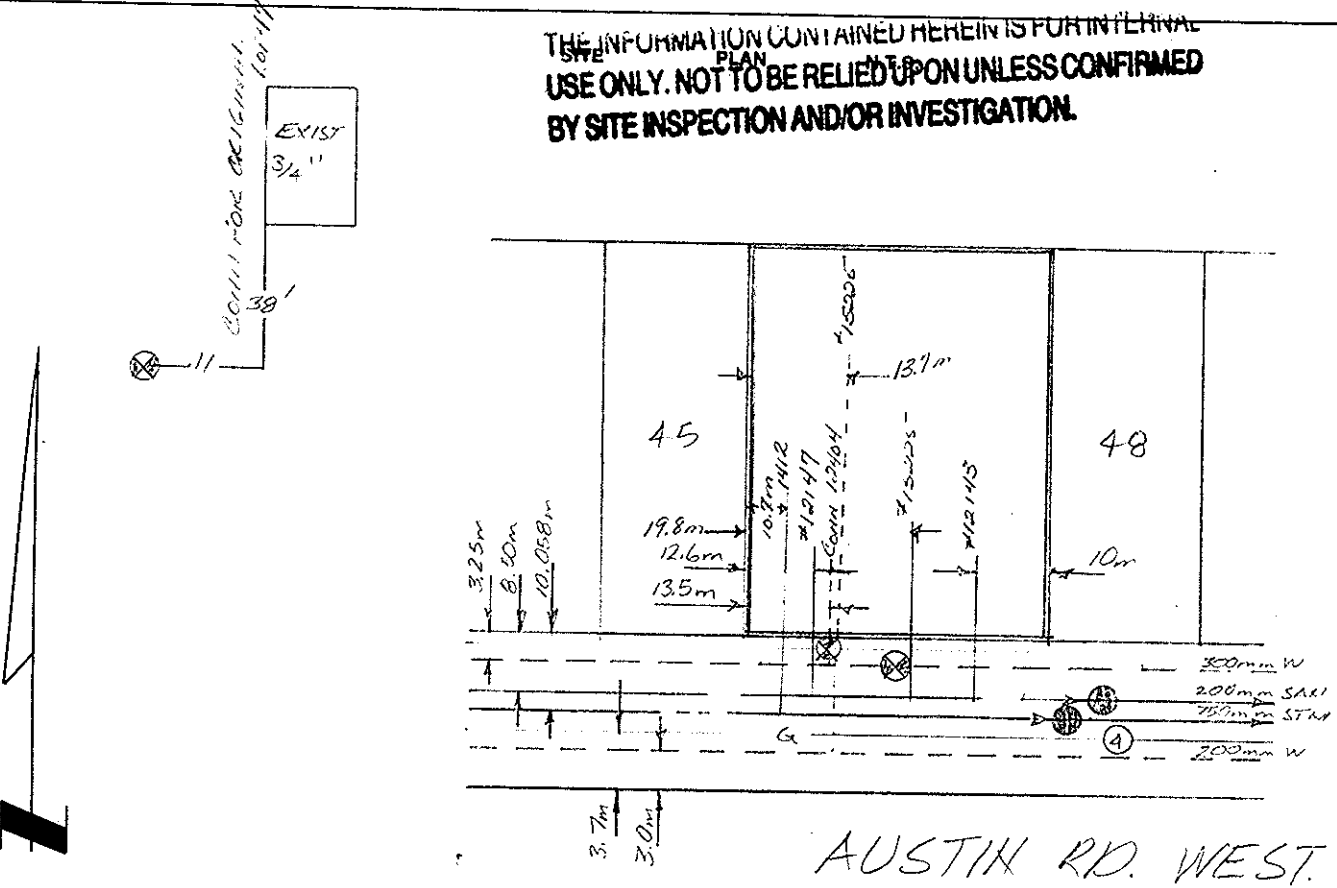

AUSTIN RD. WEST.