

City of Prince George HISTORY SHEET

SHEET NUMBER _____ Roll Number **PG5105**

Legal: LOT'S **Pl. 1 (28²⁶)** BLOCK _____ D.L. **4047** PLAN **9543**

Address: **3858 AUSTIN ROAD WEST**

Sanitary Connection: # **15225** **12143 12147** SIZE **100mm 100mm** MATERIAL _____ INV. **CONV. 12143-759.120** **12147-757.413** **CONNECTED**

Water Connection # **15225** **12404** SIZE **50mm** **EXISTING 200mm** MATERIAL **COPPER** METER _____ CONNECTED

Storm Connection: # **1412** SIZE **150mm** MATERIAL _____ INV. _____ CONNECTED

Cash Receipt No's: WATER **12409 15225** SANITARY **12143 15225** STORM **12143**

CURB FROM PROPERTY LINE _____ PAVEMENT WIDTH _____

B.C. HYDRO **O.H.** UNDERGROUND CONNECTION _____


B.C. TELEPHONE **O.H.** UNDERGROUND CONNECTION _____

INLAND GAS **AS SHOWN**

Information Sheets: **579 NIL** **579 15' W**

Comments: **OLD LOT 11**
NID. WATER SERVICE - 8' EAST OF POWER POLE - IN SMALL BOX

**THE INFORMATION CONTAINED HEREIN IS FOR INTERNAL
SITE PLAN USE ONLY. NOT TO BE RELIED UPON UNLESS CONFIRMED
BY SITE INSPECTION AND/OR INVESTIGATION.**

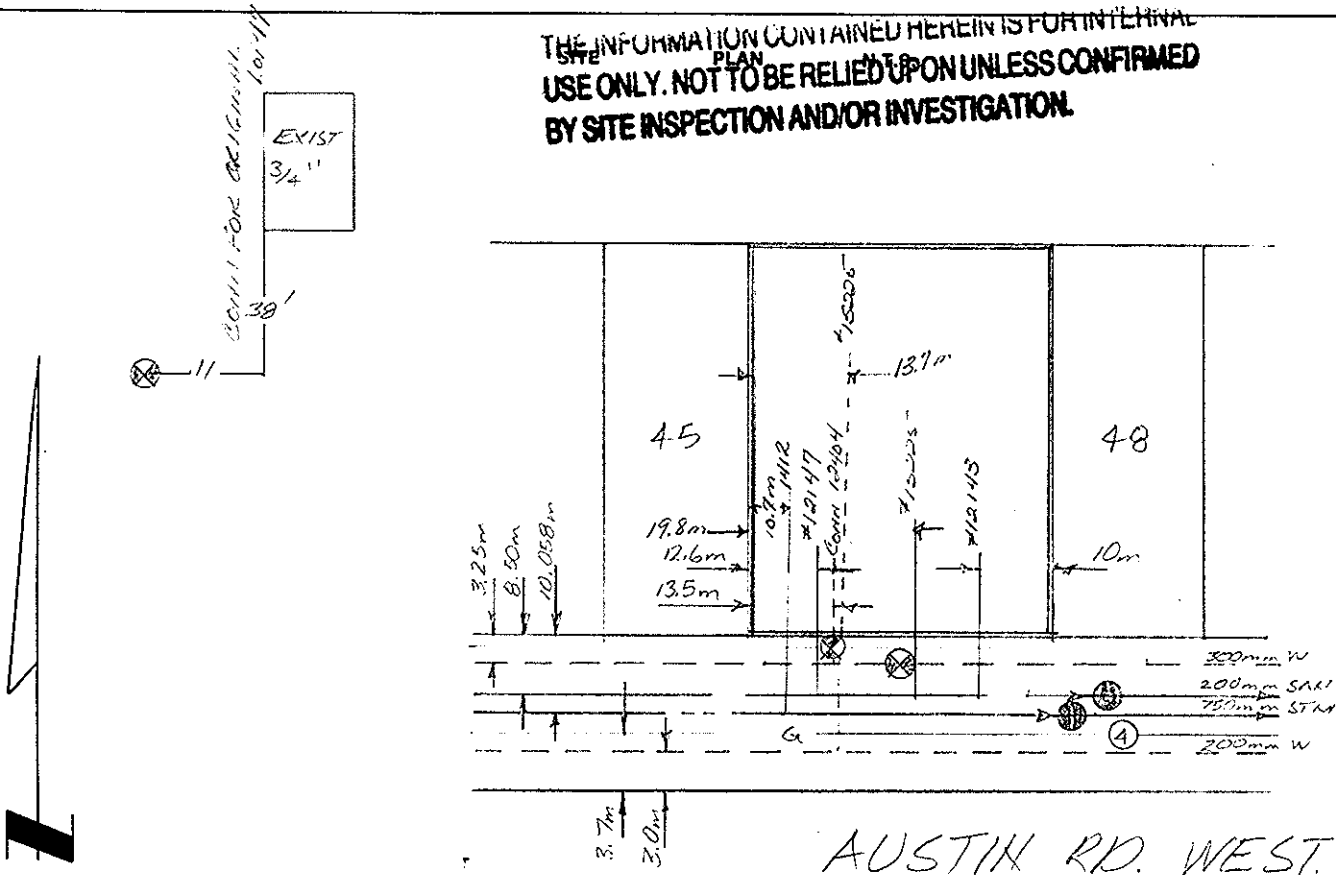

AUSTIN RD. WEST.