

# City of Prince George HISTORY SHEET

SHEET NUMBER \_\_\_\_\_ Roll Number **PGS105**

Legal: LOT'S **R. 1 (28363)** BLOCK \_\_\_\_\_ D.L. **4047** PLAN **9543**

Address: **3858 AUSTIN ROAD WEST**

Sanitary Connection: # **15225** SIZE **100mm** MATERIAL \_\_\_\_\_ INV. **CONN. 1247-759.120** **1247-757.413** **CONNECTED**

Water Connection # **15225** SIZE **50mm** MATERIAL **COPPER** METER \_\_\_\_\_ **CONNECTED**

Storm Connection: # **1412** SIZE **150mm** MATERIAL \_\_\_\_\_ INV. \_\_\_\_\_ **CONNECTED**

Cash Receipt No's: WATER **12404 15225** SANITARY **12147 15225** STORM **1213**

CURB FROM PROPERTY LINE \_\_\_\_\_ PAVEMENT WIDTH \_\_\_\_\_

B.C. HYDRO **D.H.** UNDERGROUND CONNECTION \_\_\_\_\_


B.C. TELEPHONE **D.H.** UNDERGROUND CONNECTION \_\_\_\_\_

INLAND GAS **A.S. SHOWN**

Information Sheets: **579 N11, 579 15' W**

Comments: **NID. WATER SERVICE - 8' EAST OF POWER PULL-IN SMALL BOX**

**THE INFORMATION CONTAINED HEREIN IS FOR INTERNAL  
USE ONLY. NOT TO BE RELIED UPON UNLESS CONFIRMED  
BY SITE INSPECTION AND/OR INVESTIGATION.**

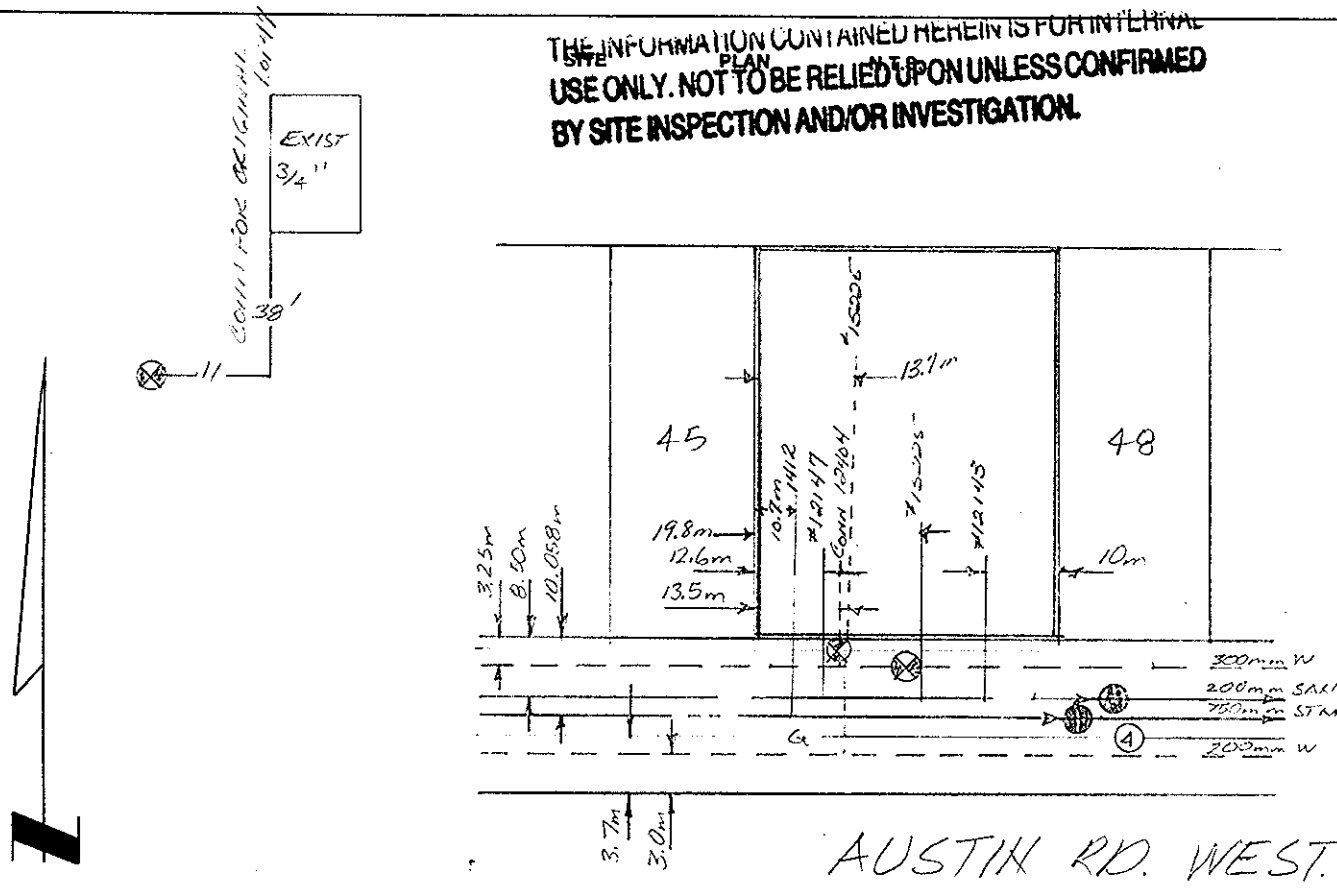

**AUSTIN RD. WEST.**