

# City of Prince George HISTORY SHEET

SHEET NUMBER

Roll Number

*PGS105*

Legal: LOT'S *R. 1 (28263)* BLOCK

D.L. *4047*

PLAN *9543*

Address: *3858 AUSTIN ROAD WEST*

Sanitary Connection: # *15225* SIZE *100mm* MATERIAL *100mm* INV. *CONV. 1243-739.120* *1247-757.418* **CONNECTED**

Water Connection # *15225* SIZE *50mm* MATERIAL *COPPER* METER **CONNECTED**

Storm Connection: # *1412* SIZE *150mm* MATERIAL INV. **CONNECTED**

Cash Receipt No's: WATER *12409 2159* SANITARY *12102 2274* STORM *15325 372* *12143 2213* *374*

CURB FROM PROPERTY LINE

PAVEMENT WIDTH

B.C. HYDRO *O.H.* UNDERGROUND CONNECTION


B.C. TELEPHONE *O.H.* UNDERGROUND CONNECTION

INLAND GAS *AS SHOWN*

Information Sheets: *579 NIL, 579 15' W*

Comments: *NID. WATER SERVICE - 8' EAST OF POWER PILE - IN SMALL BOX*

THE INFORMATION CONTAINED HEREIN IS FOR INTERNAL  
USE ONLY. NOT TO BE RELIED UPON UNLESS CONFIRMED  
BY SITE INSPECTION AND/OR INVESTIGATION.

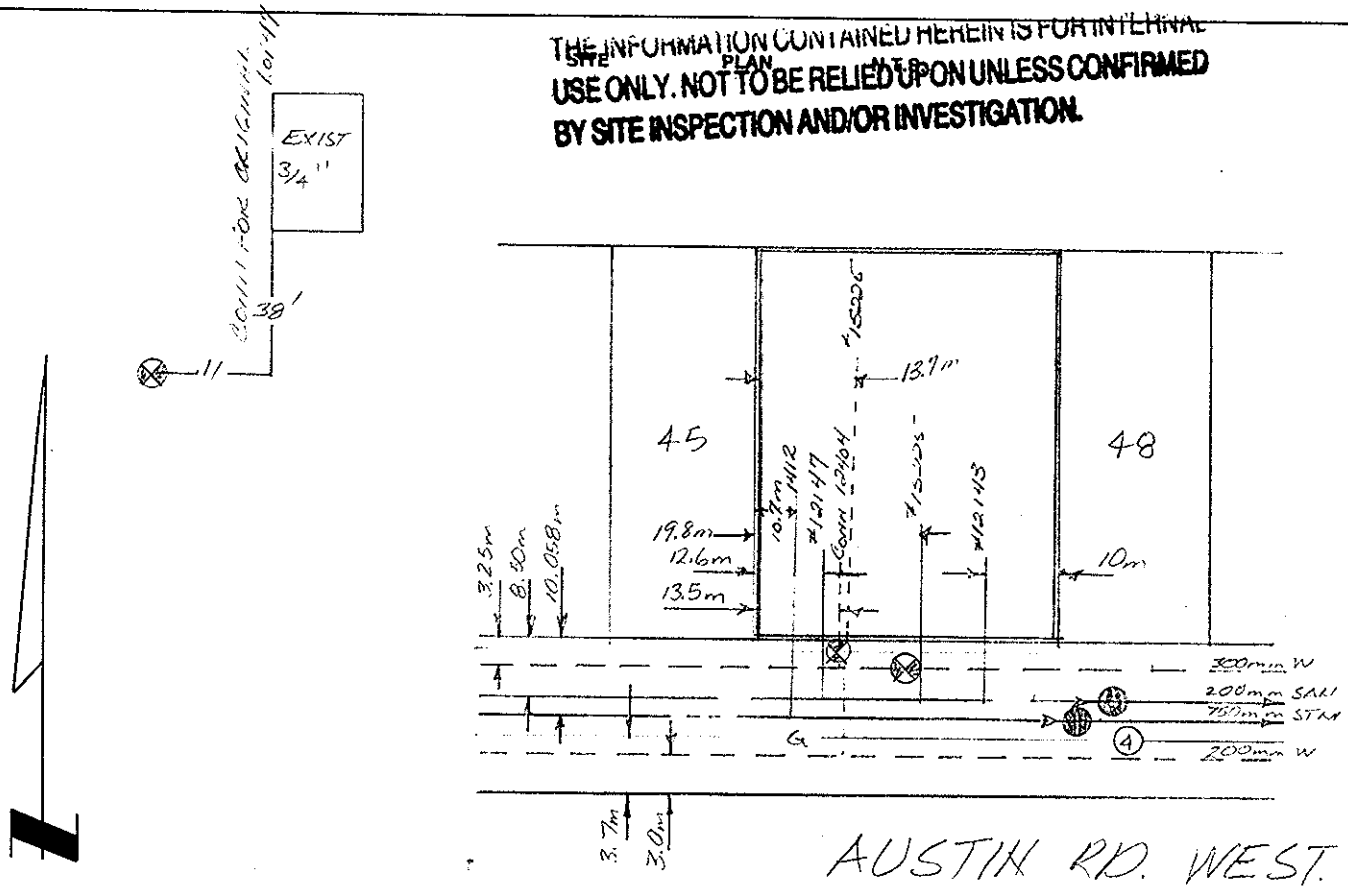

*AUSTIN RD. WEST.*