

# City of Prince George HISTORY SHEET

SHEET NUMBER

Roll Number

*PGS105*

Legal: LOT'S *P. 1 (28363)* BLOCK

D.L. *4047*

PLAN *9543*

Address: *3858 AUSTIN ROAD WEST*

Sanitary Connection: # *15225* *12143* *12147* SIZE *100mm* *100mm* MATERIAL

CONN: *12143-759.120*  
INV. CONN: *12147-757.913* CONNECTED

Water Connection # *15225* *12104* *1150* SIZE *20mm* *3/4"* MATERIAL *COPPER* METER

CONNECTED

Storm Connection: # *1412* SIZE *150mm* MATERIAL

INV. CONNECTED

Cash Receipt No's: WATER *12409* *15225* *12143* *15225* *12143*  
*259* *373* *2274* *372* *2073* SANITARY STORM *274*

CURB FROM PROPERTY LINE

PAVEMENT WIDTH

B.C. HYDRO *O.H.*

UNDERGROUND CONNECTION

B.C. TELEPHONE *O.H.*

UNDERGROUND CONNECTION


INLAND GAS *AS SHOWN*

Information Sheets:

*579 NIL, 579 15' W*

Comments: *OLD LOT 44*  
*NID. WATER SERVICE - 8' EAST OF POWER PULL-IN SMALL BOX*

**THE INFORMATION CONTAINED HEREIN IS FOR INTERNAL  
SITE PLAN USE ONLY. NOT TO BE RELIED UPON UNLESS CONFIRMED  
BY SITE INSPECTION AND/OR INVESTIGATION.**

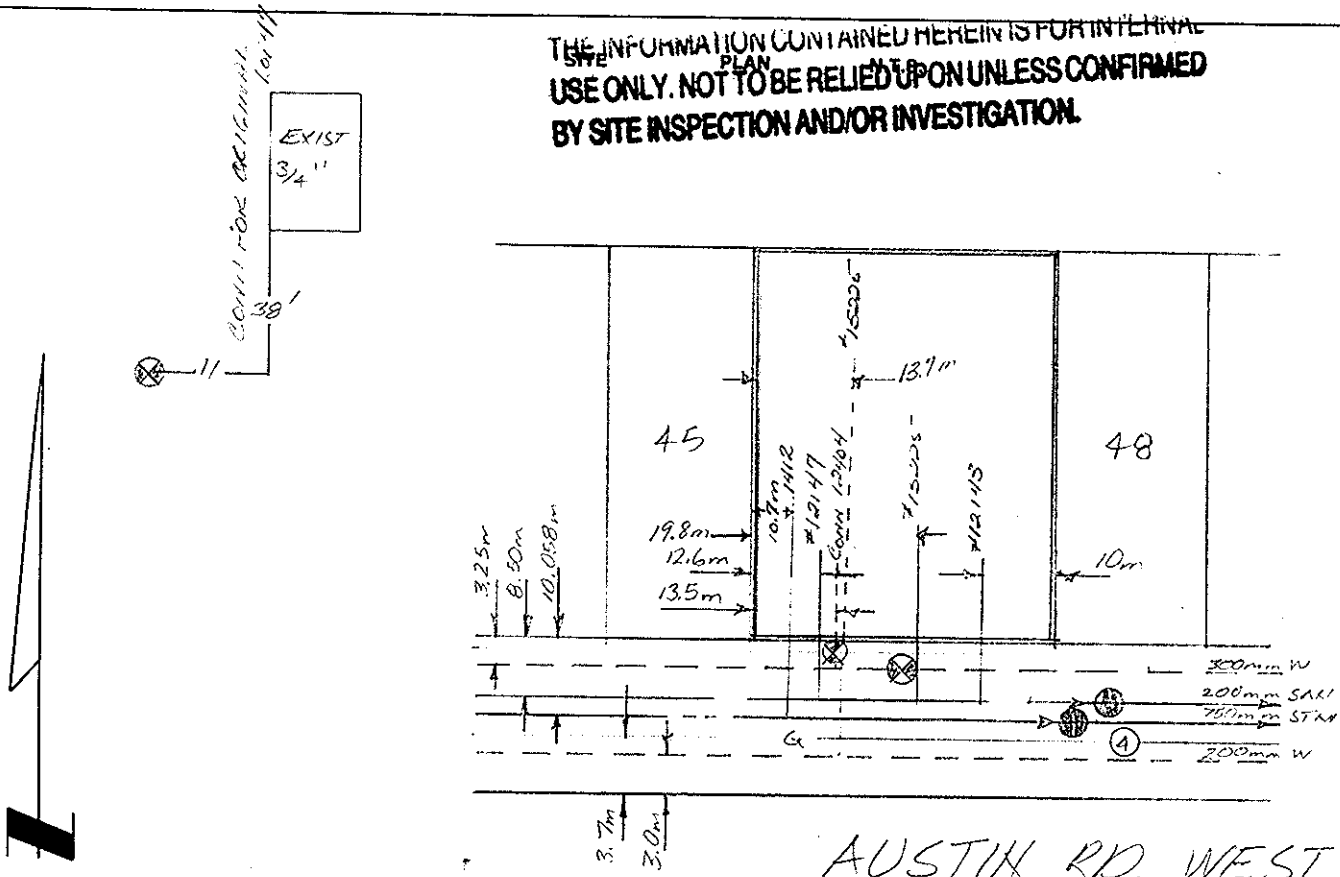

AUSTIN RD. WEST.