

City of Prince George HISTORY SHEET

SHEET NUMBER _____ Roll Number **PG5105**

Legal: LOT'S **R. 1 (28363)** BLOCK _____ D.L. **4047** PLAN **9543**

Address: **3858 AUSTIN ROAD WEST**

Sanitary Connection: # **15225** **12143 12147** SIZE **100mm to 100mm** MATERIAL _____ INV. **CON. 12143-739.120** **12147-737.418** **CONNECTED**

Water Connection # **15225** **12404** SIZE **50mm** MATERIAL **COPPER** METER _____ **CONNECTED**

Storm Connection: # _____ SIZE **150mm** MATERIAL _____ INV. _____ **CONNECTED**

Cash Receipt No's: WATER **12409 15225** SANITARY **12143 15225** STORM **12143**

CURB FROM PROPERTY LINE _____ PAVEMENT WIDTH _____

B.C. HYDRO **O.H.** UNDERGROUND CONNECTION _____


B.C. TELEPHONE **O.H.** UNDERGROUND CONNECTION _____

INLAND GAS **AS SHOWN**

Information Sheets: _____ **579 NIL 579 15' W**

Comments: **CID Lot 11**
NID. WATER SERVICE - 8' EAST OF POWER POLE - IN SMALL BOX

THE INFORMATION CONTAINED HEREIN IS FOR INTERNAL
SITE PLAN USE ONLY. NOT TO BE RELIED UPON UNLESS CONFIRMED
BY SITE INSPECTION AND/OR INVESTIGATION.

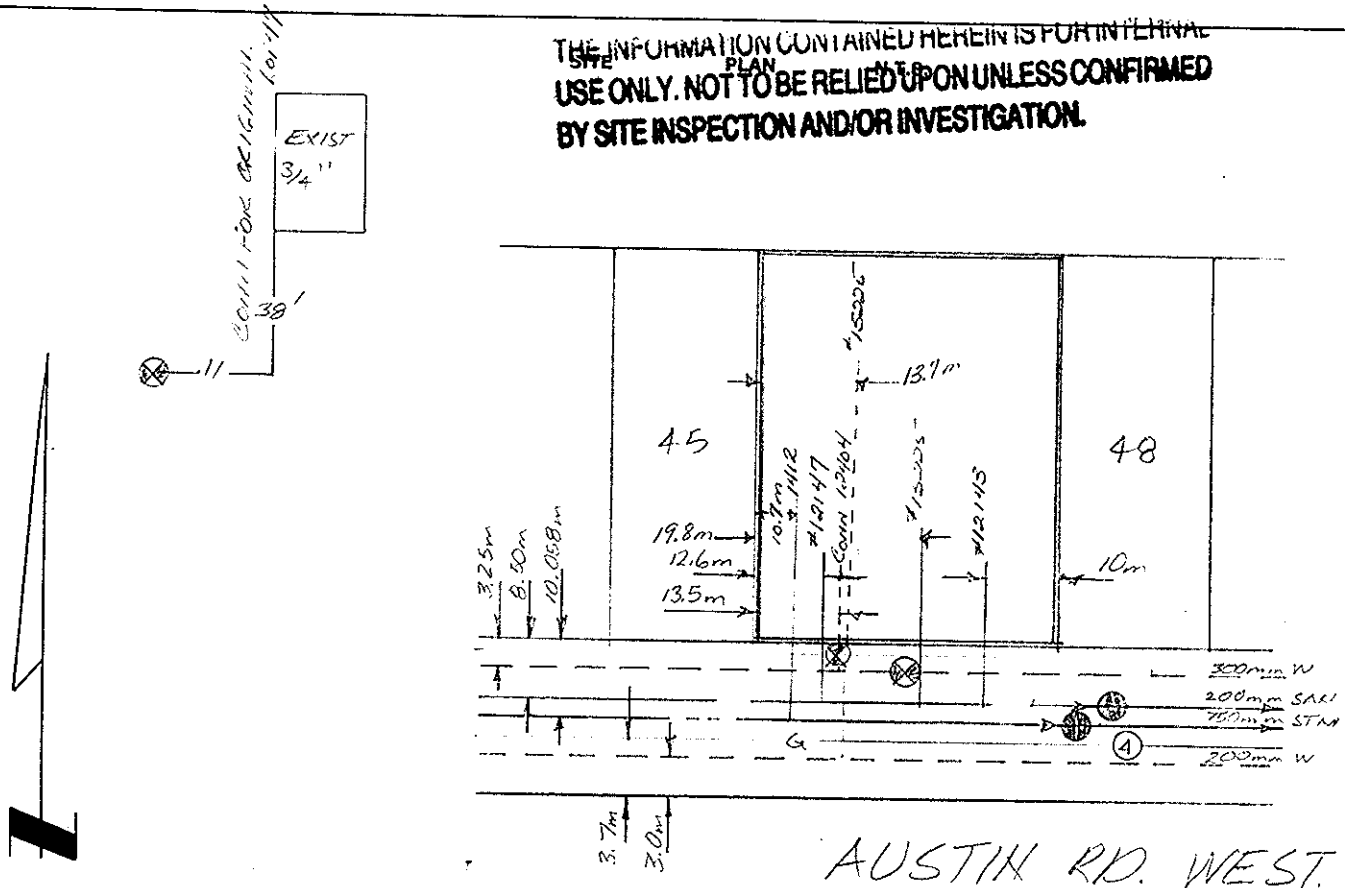

AUSTIN RD. WEST.