

City of Prince George HISTORY SHEET

SHEET NUMBER

Roll Number

Legal: LOT'S A BLOCK D.L. 343 PLAN R65106

Address: 1965 1st AVENUE

Sanitary Connection: # 15227 SIZE 100 mm MATERIAL INV. CONNECTED

Water Connection # 15227 SIZE 40 mm MATERIAL METER CONNECTED

Storm Connection: # 1415 SIZE MATERIAL INV. CONNECTED

Cash Receipt No's: WATER 16722, 667 SANITARY 382 STORM (16722), 668

CURB FROM PROPERTY LINE PAVEMENT WIDTH 54'


B.C. HYDRO O.H. UNDERGROUND CONNECTION

B.C. TELEPHONE O.H. UNDERGROUND CONNECTION

INLAND GAS ON FIRST AVENUE 6" Ø MAIN

Information Sheets: 410

Comments:

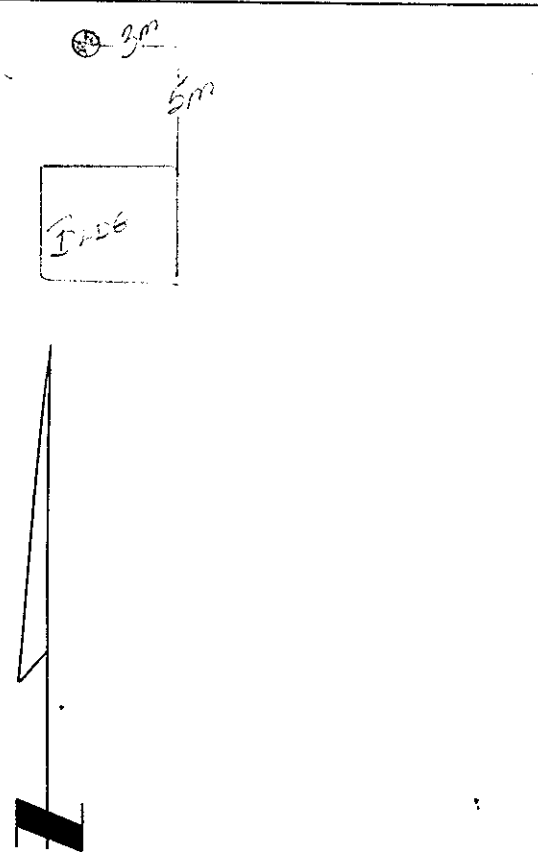

SITE PLAN N.T.S.

FIRST AVENUE

