


# City of Prince George HISTORY SHEET

SHEET NUMBER	Roll Number
Legal: LOT'S <u>A</u> BLOCK _____ D.L. <u>343</u> PLAN <u>R65106</u>	
Address: <u>1965 1st AVENUE</u>	
Sanitary Connection: # <u>15227</u> SIZE <u>100 mm</u> MATERIAL _____ INV. _____ CONNECTED _____	
Water Connection # <u>15227</u> SIZE <u>40 mm</u> MATERIAL _____ METER _____ CONNECTED _____	
Storm Connection: # <u>1715</u> SIZE _____ MATERIAL _____ INV. _____ CONNECTED _____	
Cash Receipt No's: WATER <u>(16722) 667</u> SANITARY <u>382</u> STORM <u>(16722) 668</u>	
CURB FROM PROPERTY LINE _____	PAVEMENT WIDTH <u>54'</u>
B.C. HYDRO <u>O.H.</u> _____	UNDERGROUND CONNECTION _____
B.C. TELEPHONE <u>O.H.</u> _____	UNDERGROUND CONNECTION _____
INLAND GAS <u>ON FIRST AVENUE 6" Ø MAIN</u>	
Information Sheets: <u>410</u>	
Comments: _____	



SITE PLAN N.T.S.  
FIRST AVENUE

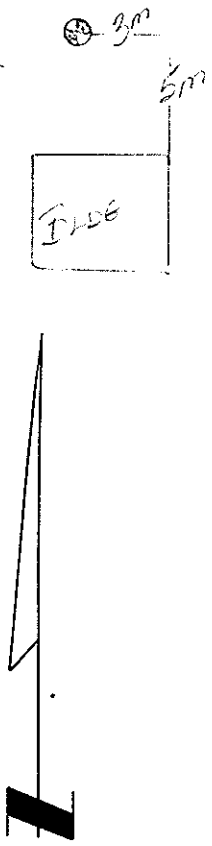