

**City of Prince George
HISTORY SHEET**

JUN 20 1977
935

SHEET NUMBER _____ Roll Number _____

Legal: LOT'S 57-28 BLOCK 8 D.L. 932 PLAN 796

Address: 2131 Norwood St

Sanitary Connection: # 6724 SIZE 100mm MATERIAL A.C. INV. _____ CONNECTED

Water Connection # 6682 SIZE 20mm MATERIAL CU. METER _____ CONNECTED

Storm Connection: # _____ SIZE _____ MATERIAL _____ INV. _____ CONNECTED

Cash Receipt No's: WATER _____ SANITARY _____ STORM _____

CURB FROM PROPERTY LINE _____ PAVEMENT WIDTH _____


B.C. HYDRO 0/H UNDERGROUND CONNECTION _____

B.C. TELEPHONE 0/H UNDERGROUND CONNECTION _____

INLAND GAS AS SHOWN

Information Sheets: _____

Comments: WITH THAW WIRE;

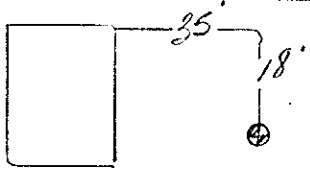

SITE PLAN N.T.S.

NORWOOD ST.

