

City of Prince George

HISTORY SHEET

SHEET NUMBER

PID # 004535618

Legal: LOTS 377 BLOCK D.L. 937 PLAN 15 185

Address: 664 UNION ST.

Sanitary Connection: # 4648 SIZE 100 mm MATERIAL A.C. INV. 601.951 CONNECTED ✓

Water Connection: # 4648 SIZE 20 mm MATERIAL C.U. METER CONNECTED ✓

Storm Connection: # SIZE mm MATERIAL INV. CONNECTED

Cash Receipt No's: WATER PAID IN LOT PRICE SANITARY PAID IN LOT PRICE STORM

CURB FROM PROPERTY LINE 4.877 m PAVEMENT WIDTH 10.363 m

B.C. HYDRO U/G UNDERGROUND CONNECTION



B.C. TELEPHONE U/G UNDERGROUND CONNECTION

INLAND GAS 3.657 m FROM R.

Information Sheets:

Comments:

**THE INFORMATION CONTAINED HEREIN IS FOR INTERNAL USE ONLY.
NOT TO BE RELIED UPON UNLESS CONFIRMED BY SITE INSPECTION AND/OR INVESTIGATION**

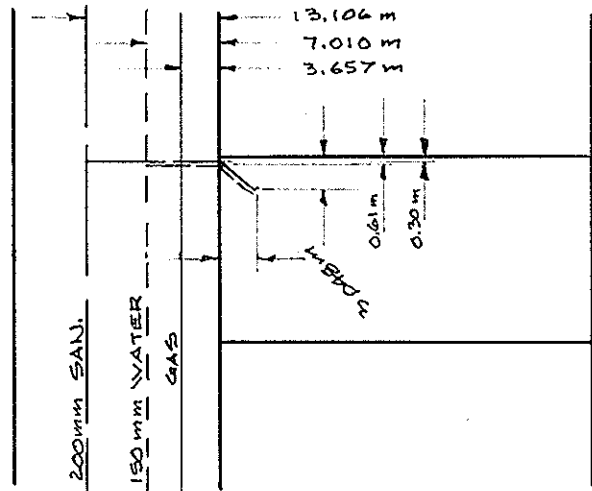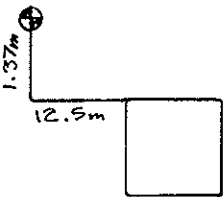

UNION ST.

