
## City of Prince George HISTORY SHEET

SHEET NUMBER 2165					Roll Number 004568630			
Legal: LOT'S 15	BLC	OCK		D.L.	633	PLAN	25177	
Address: 5832	KOVACH	CH D	RIVE					
Sanitary Connection: #	S	IZE 100 M	MATERIAL	PVC	INV. 671-34	<del>l</del> m	CONNECTED	
Water Connection #	S	<sub>IZE</sub> 20 m #	MATERIAL	cu	METER		CONNECTED	
Storm Connection: #	s	IZE (00 m	n Ø MATERIAL	PVC	INV. 671.3	m	CONNECTED	
Cash Receipt No's:	WATER		SANITARY		S	ORM		
CURB FROM PROPERTY LINE 5 m PAVEMENT WIDTH 10 m						о м		
B.C. HYDRO U/G CONNECTION @ MID LOT UNDERGROUND CONNECTION AT KIOSK								
BC TELEPHONE U/G CONNECTION @ MID LOT								
HE IN CALLY NOT TO BE RELIED UPON UNLESS CONFIRMED								
INLAND GAS  BY SITE INSPECTION AND/OR INVESTIGATION.  Information Sheets:								
	ODETIC B	ENCH 1	MARK E	L . 687	2.067 m			
BLACKBURN ELEMENTARY SCHOOL GYM								
TABLET ON CONCRETE WALL NORTH SIDE								

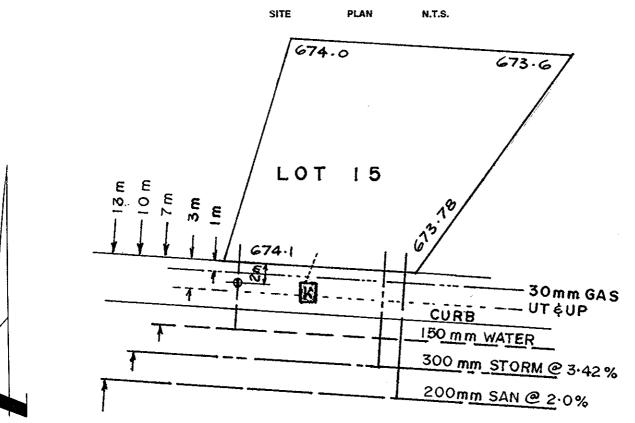

KOVACHICH STREET