

**City of Prince George  
HISTORY SHEET**

SHEET NUMBER **2226** Roll Number **004568753**

Legal: LOT'S **40** BLOCK \_\_\_\_\_ D.L. **633** PLAN **25177**

Address: **1874 BACHINSKI CRES.**

Sanitary Connection: # \_\_\_\_\_ SIZE **100 mm  $\phi$**  MATERIAL **PVC** INV. **673.4 m** CONNECTED

Water Connection # \_\_\_\_\_ SIZE **20 mm  $\phi$**  MATERIAL **Cu** METER \_\_\_\_\_ CONNECTED

Storm Connection: # \_\_\_\_\_ SIZE **100 mm  $\phi$**  MATERIAL **PVC** INV. **673.1 m** CONNECTED

Cash Receipt No's: WATER \_\_\_\_\_ SANITARY \_\_\_\_\_ STORM \_\_\_\_\_

CURB FROM PROPERTY LINE **5 m** PAVEMENT WIDTH **10 m**

B.C. HYDRO **U/G CONNECTION @ MID LOT** UNDERGROUND CONNECTION \_\_\_\_\_


B.C. TELEPHONE **U/G CONNECTION @ MID LOT.** UNDERGROUND CONNECTION \_\_\_\_\_

INLAND GAS \_\_\_\_\_

Information Sheets: \_\_\_\_\_

Comments: **GEODETIC BENCH MARK EL. 682.067 m**  
**BLACKBURN ELEMENTARY SCHOOL GYM**  
**TABLET ON CONCRETE WALL - NORTH SIDE**

SITE PLAN N.T.S.

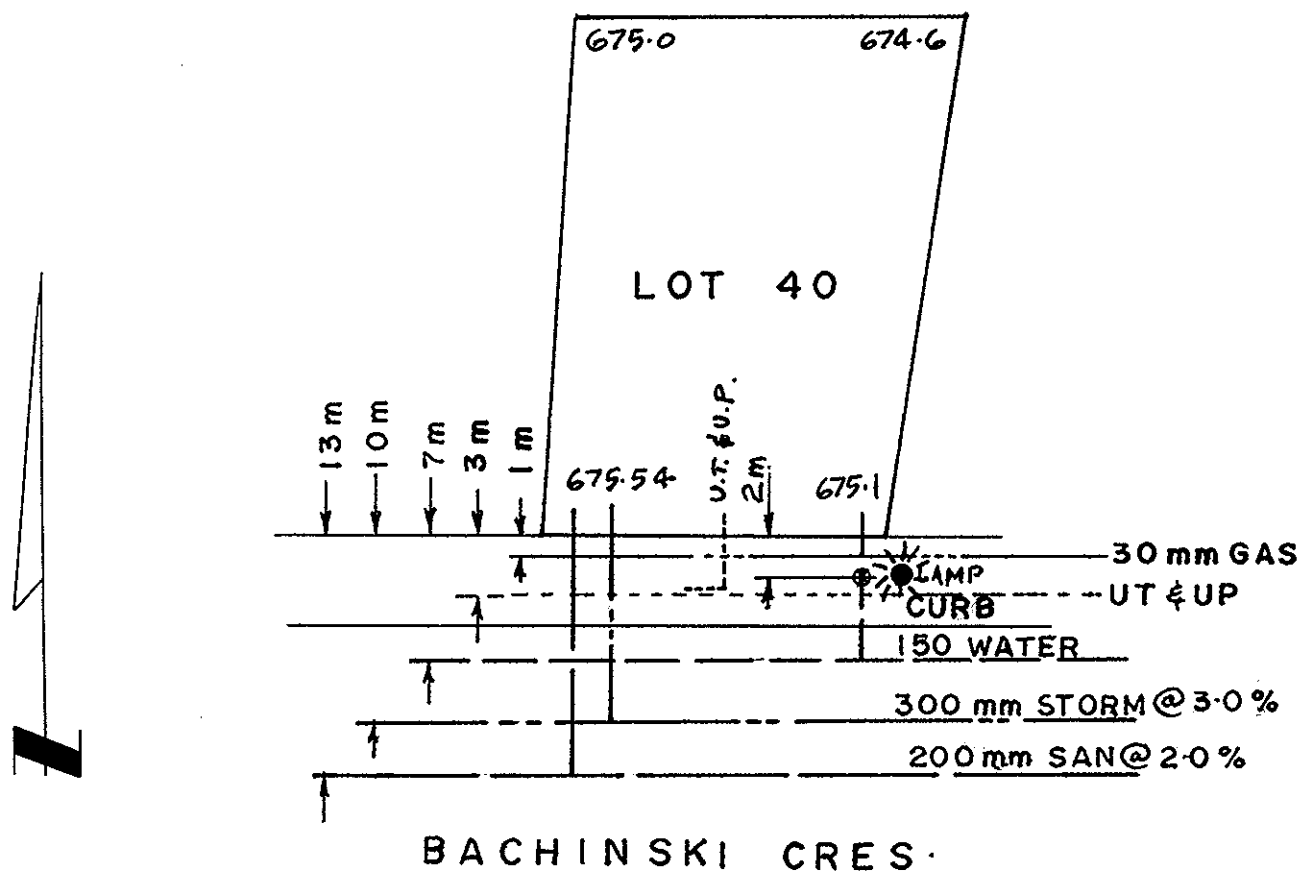

**BACHINSKI CRES.**