

City of Prince George HISTORY SHEET

SHEET NUMBER

Roll Number 00458/857

Legal: LOT'S 74 BLOCK — D.L. 2608 PLAN 19520

Address: 269 Boyd St

Sanitary Connection: # 7365 SIZE 100 mm MATERIAL A.C. INV. CONNECTED

Water Connection # 7365 SIZE 20 mm MATERIAL Cu METER CONNECTED

Storm Connection: # SIZE MATERIAL INV. CONNECTED

Cash Receipt No's: WATER SANITARY STORM

CURB FROM PROPERTY LINE 4.877 m PAVEMENT WIDTH 10.363

B.C. HYDRO U/G UNDERGROUND CONNECTION



B.C. TELEPHONE U/G UNDERGROUND CONNECTION

INLAND GAS AS SHOWN

Information Sheets:

Comments: WITH THAW WIRE.

**THE INFORMATION CONTAINED HEREIN IS FOR INTERNAL USE ONLY.
NOT TO BE RELIED UPON UNLESS CONFIRMED BY SITE INSPECTION AND/OR INVESTIGATION**

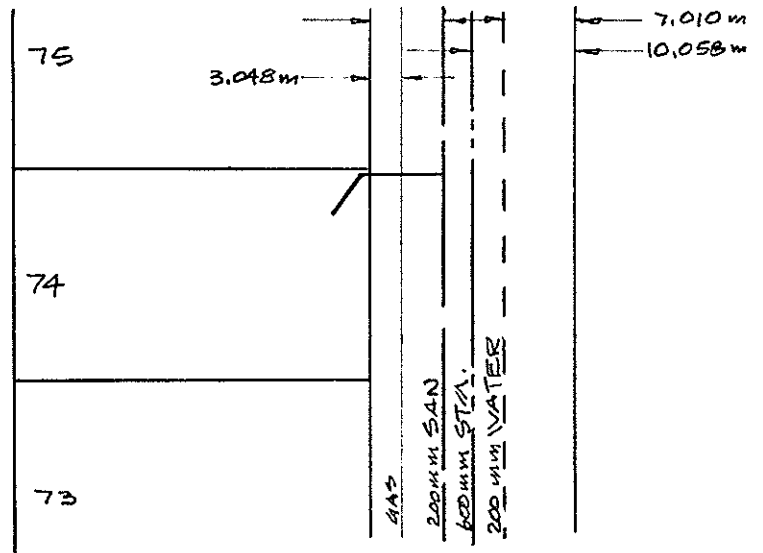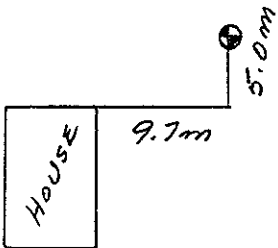

BOYD ST.

