



City of Prince George HISTORY SHEET

SHEET NUMBER		Roll Number 004587-29			
Legal:	LOT'S 29	BLOCK	D.L. 2611	PLAN	21607
Address: 2311 OLDS ST.					
Sanitary Connection:	# 9229	SIZE 4"	MATERIAL A.C	INV. 71.92	CONNECTED
Water Connection:	# 9229	SIZE 3/4"	MATERIAL Copper	METER	CONNECTED
Storm Connection:	#	SIZE	MATERIAL	INV.	CONNECTED
Cash Receipt No's:	WATER	SANITARY	STORM		
CURB FROM PROPERTY LINE	4.877 m			PAVEMENT WIDTH	10.363 m
B.C. HYDRO	U/G	UNDERGROUND CONNECTION			
B.C. TELEPHONE	U/G	UNDERGROUND CONNECTION			
INLAND GAS	AS SHOWN				
Information Sheets:					
Comments: WATER and SANITARY CONN. IS CENTRED ON LOT WITH THAW WIRE;					

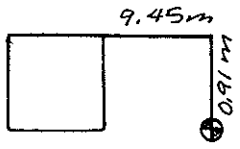

SITE PLAN N.T.S.

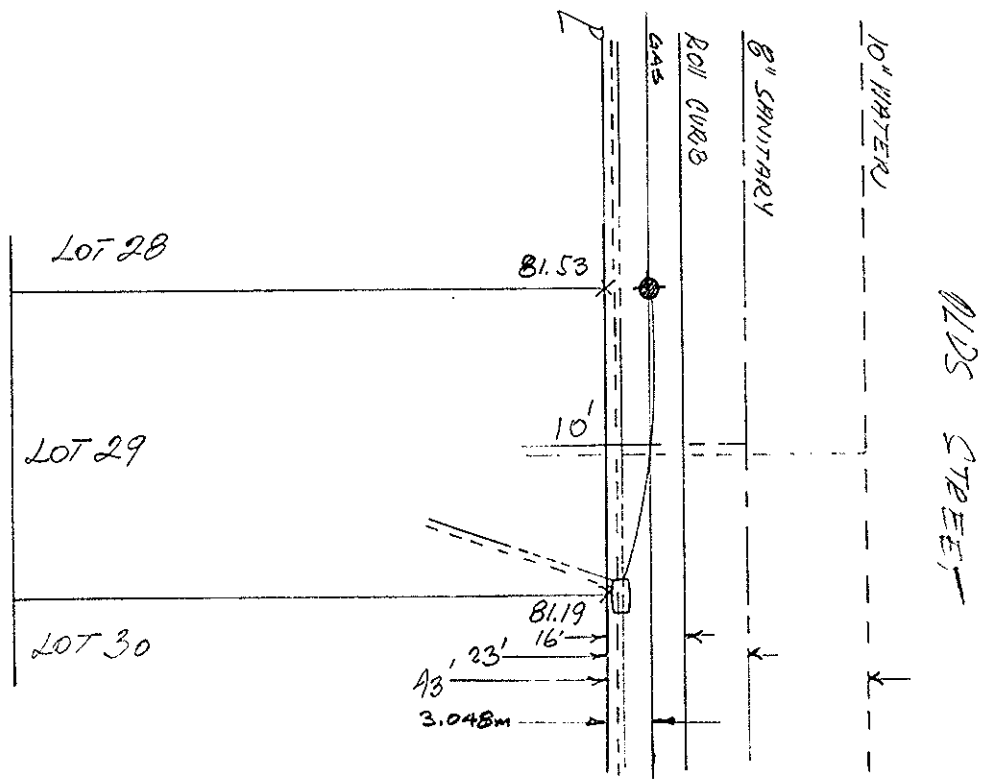

OLDS STREET