

**City of Prince George
HISTORY SHEET**

SHEET NUMBER

Roll Number 004 595912

Legal: LOT'S *Rem NE 1/4* BLOCK D.L. *634* PLAN

Address: *7575 GISCOME Rd.*

Sanitary Connection: # SIZE *100MM* MATERIAL *PVC* INV. CONNECTED

Water Connection # SIZE *20MM* MATERIAL *COPPER* METER CONNECTED

Storm Connection: # SIZE MATERIAL INV. CONNECTED

Cash Receipt No's: WATER *7130* SANITARY *7130* STORM

CURB FROM PROPERTY LINE PAVEMENT WIDTH

B.C. HYDRO UNDERGROUND CONNECTION

B.C. TELEPHONE UNDERGROUND CONNECTION


INLAND GAS

Information Sheets:

Comments:

THE INFORMATION CONTAINED HEREIN IS FOR INTERNAL USE ONLY.

NOT TO BE RELIED UPON UNLESS CONFIRMED BY SITE INSPECTION AND/OR INVESTIGATION

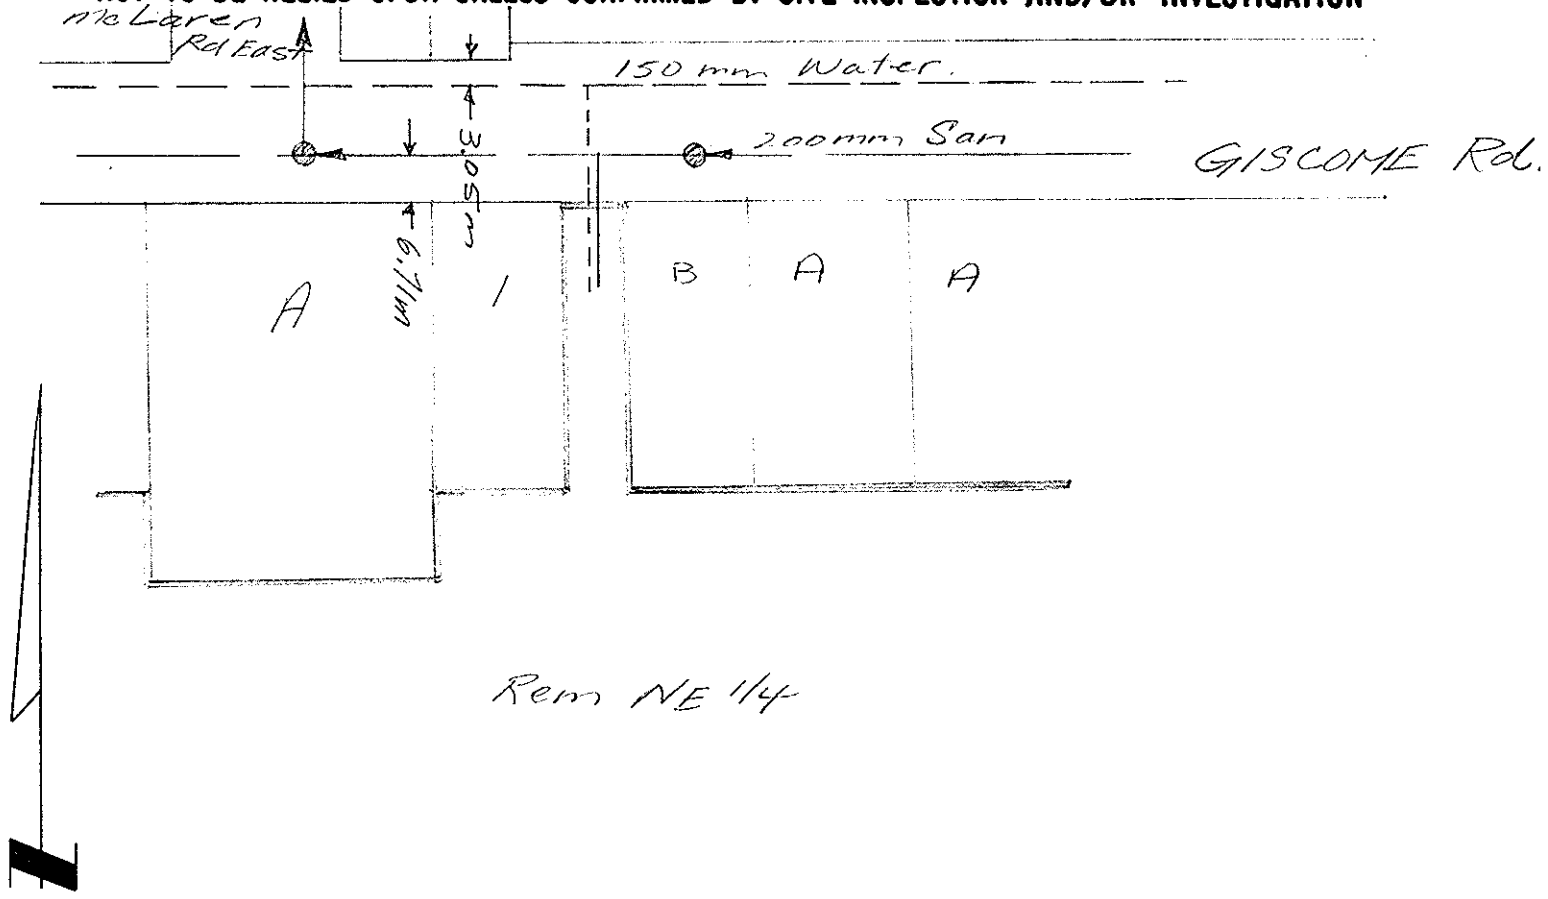

FK