



PID:	004601408
	004601416
	004601424
	004601441
	004601459
	004601491
SD/MU:	
WO:	

History Sheet

Civic Address: 650 Dominion Street

Legal Description: Lot: 7 - 12 District Lot: 343 Plan: 1268


Service Type	Diameter (mm)	Material	Invert Elev at main (m)	Invert Elev at property line (m)	Invert Elev at service end (m)	Distance into property (m)	Installation Date
Sanitary	150mm	AC	-	-	-568.00	-	January 1960
Water	50mm	Copper	-	-	-	-	2014
Storm	Unknown	Unknown	-	-	567.38	-	

Service Connection Location	Sanitary (m)	Storm (m)
150mm Sanitary service connected to San MH4911	-	
Distance from downstream Stm MH - towards upstream Stm MH	-	

Power	Size	Communications	Size	Cable	Size	Gas	Size
BC Hydro	-	Telus	-	Shaw	-	FortisBC	-
Overhead Service		Overhead Service		Overhead Service			

Installed by:	City of Prince George forces	Survey Date:	-
Comments:	New 50mm water service replaced existing 50mm water service in 2014. Old water capped.		

NOT TO SCALE The information contained herein is for internal use only.
 Not to be relied on unless confirmed by site inspection and/or investigation.

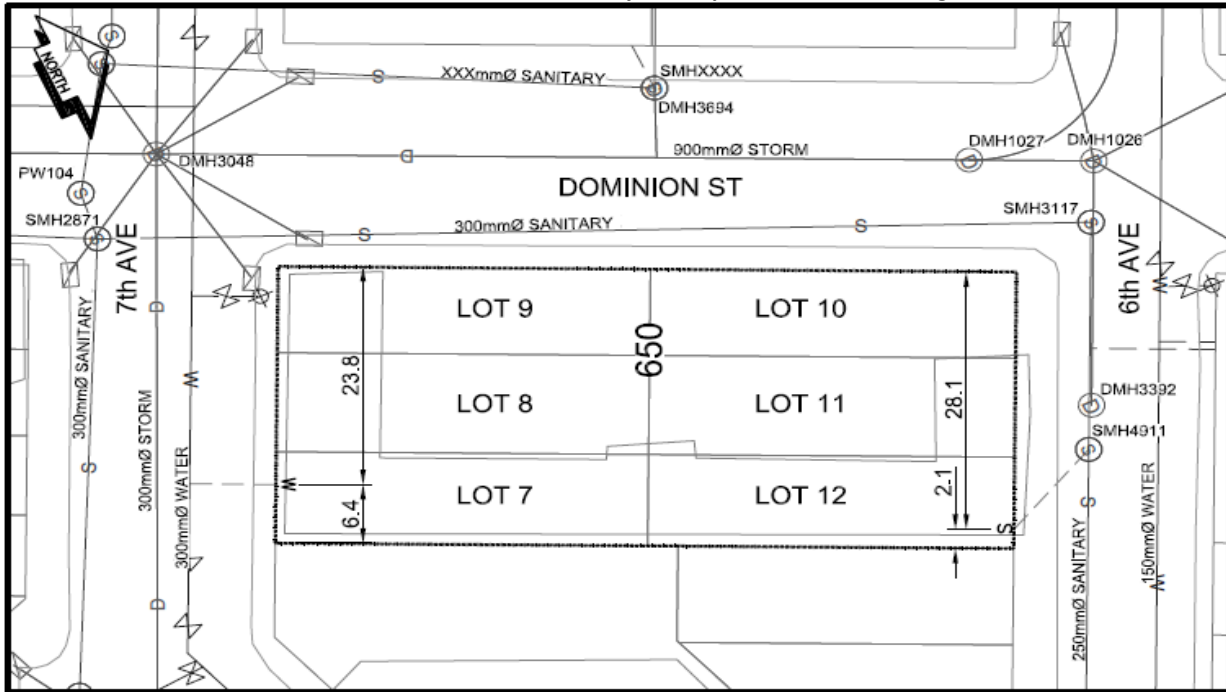

LEGEND:	
CS	CURB STOP
CO	CLEAN OUT
⊗	WATER VALVE
---	WATER SERVICE
---	SANITARY SERVICE
⊗	FIRE HYDRANT
---	STORM SERVICE
---	GAS
---	ENCUMBRANCE

NOT TO SCALE