

City of Prince George HISTORY SHEET

SHEET NUMBER

Roll Number 004601769

Legal: LOT'S 102 BLOCK _____ D.L. ~~1605~~ PLAN 23862

Address: 7760 ST. PATRICK AVE.

Sanitary Connection: # _____ SIZE 4" MATERIAL P.V.C. INV. _____ CONNECTED _____

Water Connection # _____ SIZE 3/4" MATERIAL COPPER METER _____ CONNECTED _____

Storm Connection: # _____ SIZE 4" MATERIAL P.V.C. INV. _____ CONNECTED _____

Cash Receipt No's: WATER _____ SANITARY _____ STORM _____

CURB FROM PROPERTY LINE 16' PAVEMENT WIDTH 34'


B.C. HYDRO 3' UNDERGROUND CONNECTION

B.C. TELEPHONE 3' UNDERGROUND CONNECTION

INLAND GAS 10'

Information Sheets: _____

Comments: 66' R/W

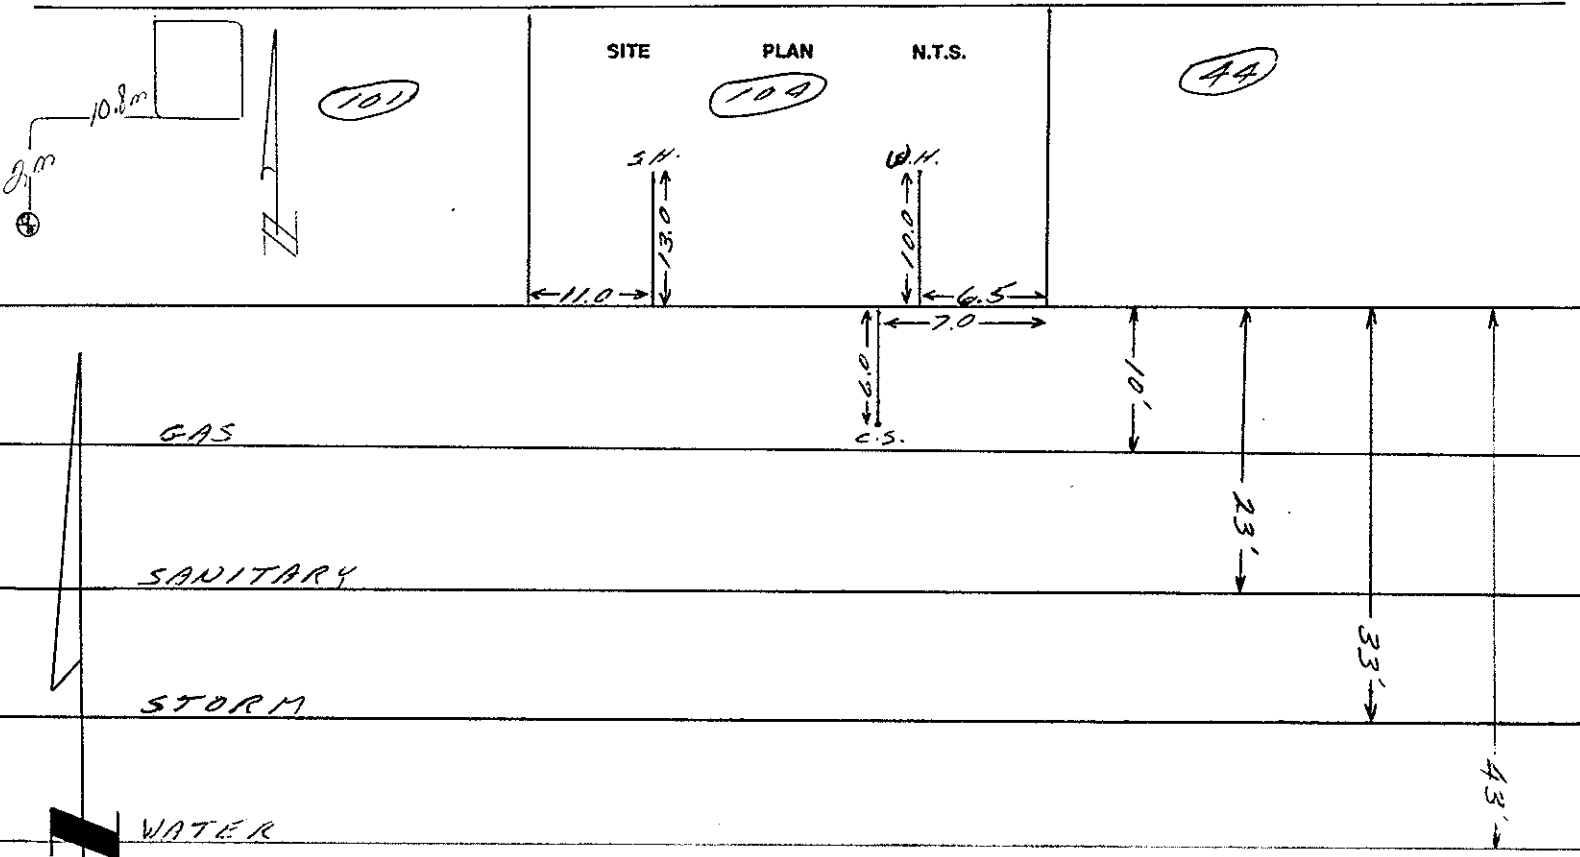

Handwritten signature/initials