

**City of Prince George  
HISTORY SHEET**

FM

SHEET NUMBER **N<sup>o</sup> 1868** Roll Number

Legal: LOT'S BLOCK D.L. 487 PLAN **PGS80**

Address: **392 KILLORENI CRES**

Sanitary Connection: # **15013** SIZE **150mm** MATERIAL INV. CONNECTED

Water Connection # **15013** SIZE **100mm** MATERIAL METER CONNECTED

Storm Connection: # **1549 & 1549** SIZE **150 & 200mm** MATERIAL INV. CONNECTED

Cash Receipt No's: WATER **2103** SANITARY **5504** STORM **3505**

CURB FROM PROPERTY LINE PAVEMENT WIDTH


B.C. HYDRO UNDERGROUND CONNECTION

B.C. TELEPHONE UNDERGROUND CONNECTION

INLAND GAS

Information Sheets:

Comments:

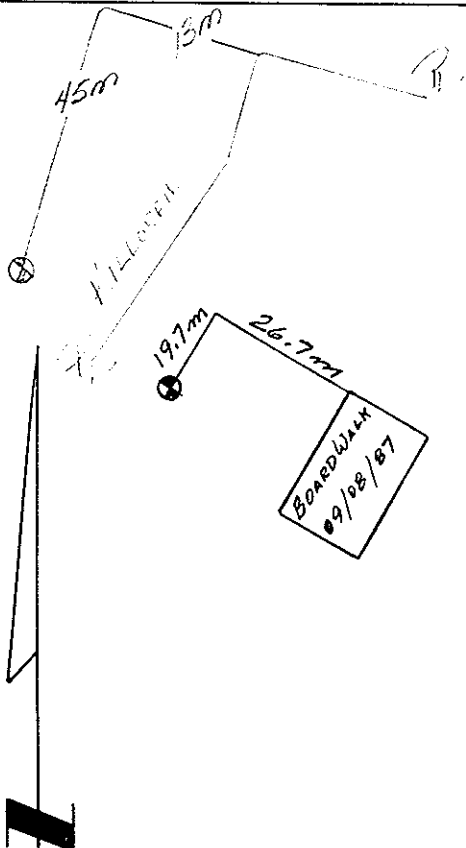

SITE PLAN N.T.S.

MULLET CRES

MULLET CRES

