

City of Prince George  
HISTORY SHEET

004605462

SHEET NUMBER 10640 Roll Number

Legal: LOT'S BLK "A" BLOCK D.L. 819 PLAN

Address: 4202 KINSLEY RD

Sanitary Connection: # SIZE MATERIAL INV. CONNECTED

Water Connection # SIZE MATERIAL METER CONNECTED

Storm Connection: # SIZE MATERIAL INV. CONNECTED

Cash Receipt No's: WATER SANITARY STORM

CURB FROM PROPERTY LINE PAVEMENT WIDTH

B.C. HYDRO UNDERGROUND CONNECTION


B.C. TELEPHONE UNDERGROUND CONNECTION

INLAND GAS

Information Sheets:

Comments:

SITE PLAN N.T.S.

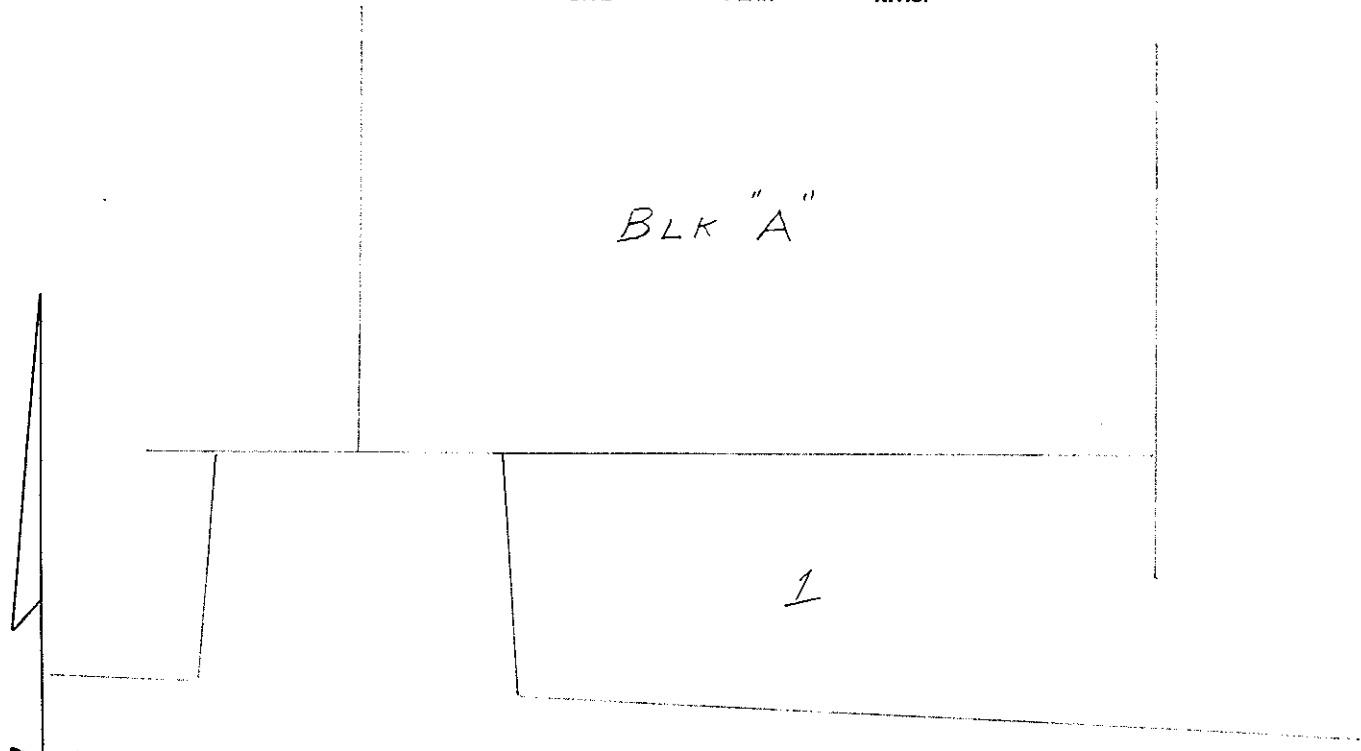

NORTHWOOD PULPMILL RD.