

**City of Prince George
HISTORY SHEET**

004605683
705

SHEET NUMBER

Roll Number

Legal: LOT'S 13-14 BLOCK 70 D.L. 937 PLAN 752

Address: 310 LYON ST.

Sanitary Connection: # 3202 SIZE 100 mm MATERIAL A.C. INV. 597.861 CONNECTED

Water Connection # 3129 SIZE 20 mm MATERIAL CU. METER CONNECTED

Storm Connection: # SIZE MATERIAL INV. CONNECTED

Cash Receipt No's: WATER SANITARY STORM

CURB FROM PROPERTY LINE 4.877m PAVEMENT WIDTH 10.363m


B.C. HYDRO 0/H UNDERGROUND CONNECTION

B.C. TELEPHONE 0/H UNDERGROUND CONNECTION

INLAND GAS 1.524m FROM R IN LANE.

Information Sheets:

Comments: WITH THAW WIRE.

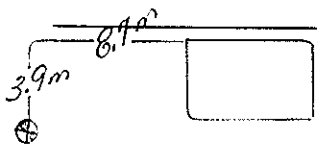

SITE PLAN N.T.S.

