
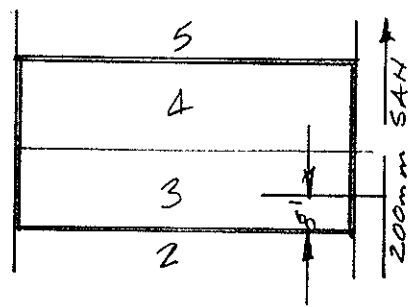


251650 511
338

City of Prince George HISTORY SHEET

SHEET NUMBER	N ^o 1321			Roll Number	
Legal:	LOT'S	3, 4	BLOCK	51	D.L. 936 PLAN 696
Address:	977 JOHNSON STREET				
Sanitary Connection:	#	1934	SIZE	MATERIAL	INV. CONNECTED
Water Connection:	#	855	SIZE	1/2" COPPER	METER CONNECTED
Storm Connection:	#		SIZE	MATERIAL	INV. CONNECTED
Cash Receipt No's:	WATER	SANITARY	STORM		
CURB FROM PROPERTY LINE	PAVEMENT WIDTH				
B.C. HYDRO	UNDERGROUND CONNECTION				
B.C. TELEPHONE	UNDERGROUND CONNECTION				
INLAND GAS					
Information Sheets:					
Comments:					

SITE PLAN N.T.S.

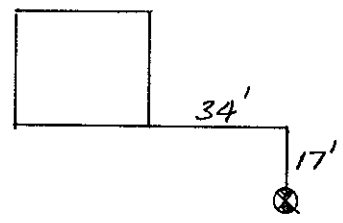

150mm WATER
JOHNSON ST.

