

20100 511
338

City of Prince George HISTORY SHEET

SHEET NUMBER **N^o 1321** Roll Number

Legal: LOT'S **3, 4** BLOCK **51** D.L. **936** PLAN **696**

Address: **977 JOHNSON STREET**

Sanitary Connection: # **1934** SIZE MATERIAL INV. CONNECTED

Water Connection # **855** SIZE **1/2"** MATERIAL **COPPER** METER CONNECTED

Storm Connection: # SIZE MATERIAL INV. CONNECTED

Cash Receipt No's: WATER SANITARY STORM

CURB FROM PROPERTY LINE PAVEMENT WIDTH

B.C. HYDRO UNDERGROUND CONNECTION



B.C. TELEPHONE UNDERGROUND CONNECTION

INLAND GAS

Information Sheets:

Comments:

SITE PLAN N.T.S.

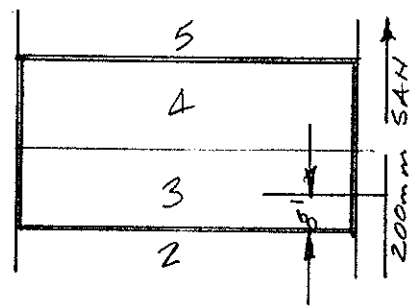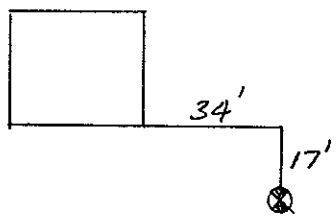

150mm WATER
JOHNSON ST.

