

**City of Prince George
HISTORY SHEET**

004656300

SHEET NUMBER **11088** Roll Number

Legal: LOT'S **5** BLOCK D.L. **4040** PLAN **8833**

Address: **4234 MYTTING ST. OR SHAMROCK RD**

Sanitary Connection: # **13370** SIZE **4"** MATERIAL INV. **2127.83** CONNECTED

Water Connection # SIZE **20mm** MATERIAL **Cu** METER CONNECTED

Storm Connection: # SIZE MATERIAL INV. CONNECTED

Cash Receipt No's: WATER SANITARY STORM

CURB FROM PROPERTY LINE PAVEMENT WIDTH

B.C. HYDRO UNDERGROUND CONNECTION

B.C. TELEPHONE UNDERGROUND CONNECTION


INLAND GAS

Information Sheets:

Comments:

SITE PLAN N.T.S.

MYTTING ST.

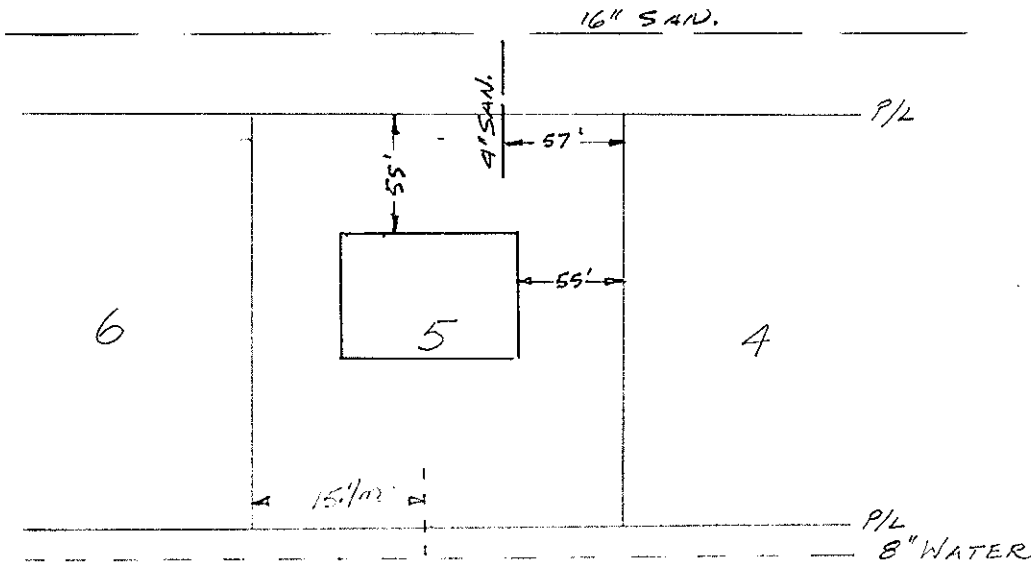

SHAMROCK RD