

**City of Prince George  
HISTORY SHEET**

2007 2011  
1974 SFG Assessment

SHEET NUMBER **8298** Roll Number **407**

Legal: LOT'S **13-14** BLOCK **11** D.L. **934** PLAN **701**

Address: **876 Hamilton Avenue**

Sanitary Connection: # SIZE **4"** MATERIAL **AC** INV. CONNECTED

Water Connection # SIZE **3/4"** MATERIAL **CU** METER CONNECTED

Storm Connection: # SIZE MATERIAL INV. CONNECTED

Cash Receipt No's: WATER SANITARY STORM

CURB FROM PROPERTY LINE PAVEMENT WIDTH

B.C. HYDRO UNDERGROUND CONNECTION

B.C. TELEPHONE UNDERGROUND CONNECTION


INLAND GAS

Information Sheets:

Comments: **The information contained herein is for internal use only. Not to be relied upon unless confirmed by site inspection and/or investigation.**

SITE PLAN N.T.S.

*Sewer*

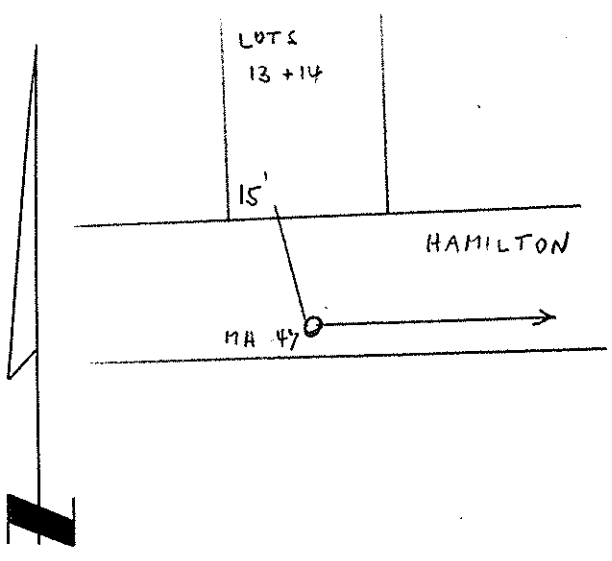

*Water*

