


City of Prince George Lot History Sheet

PID	Civic Address	Lot	Block	Plan	DL	Free Legal
004692772	429 BEECH CRES	38	5	17368	8178	

	Size (mm)	Material	Invert @ PL	Cut @ PL	Survey Date	Field Book	Location	Comments
Sanitary								
Water	200	CU					CONN# 7056	THAW WIRE
Storm								

Accuracy Not Guaranteed Unless Confirmed By Site Inspection and/or Investigation.
Sketch is Oriented North (NTS)

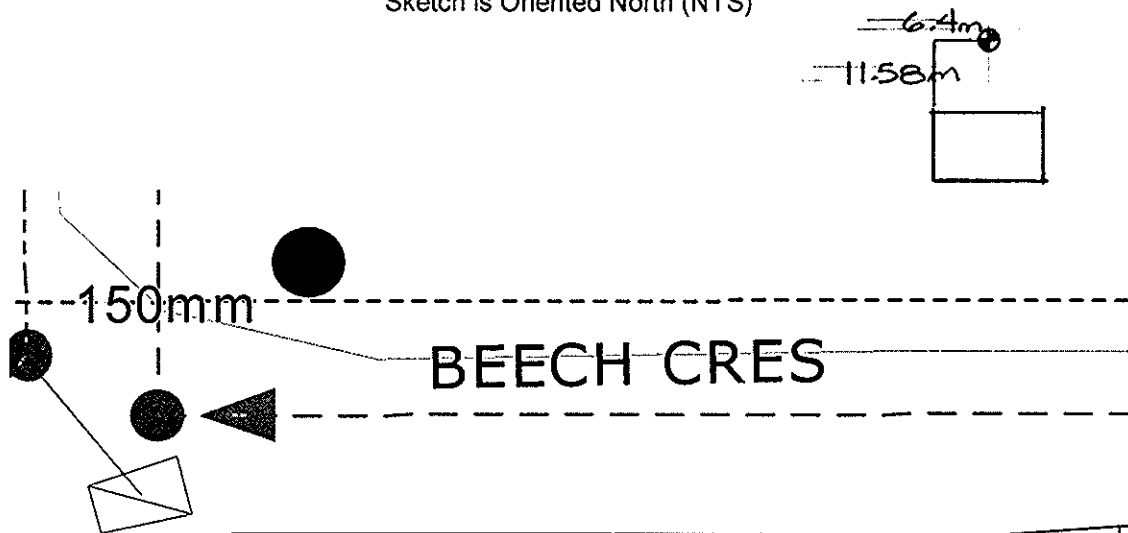

405	409	413	417	421	425	429	433	437
4	43	42	41	40	39	38	37	36