



City of Prince George

History Sheet

PID:	004694988
	004694996
SD/MU:	
WO:	

Civic Address: 1340 Douglas Street

Legal Description: Lot: 17 District Lot: 1429 Plan: 646

Lot: 18 District Lot: 1429 Plan: 646


Service Type	Diameter (mm)	Material	Invert Elev at main (m)	Invert Elev at property line (m)	Invert Elev at service end (m)	Distance into property (m)	Installation Date
Sanitary	100mm	AC	-	-	-	-	January 1957
Water	20mm	Copper	-	-	-	-	June 1959
Storm	N/A	N/A	-	-	-	-	

Service Connection Location				Sanitary (m)	Storm (m)
Distance from downstream San MH	731	towards upstream San MH	735	50.93	
Distance from downstream Stm MH	-	towards upstream Stm MH	-		

Power	Size	Communications	Size	Cable	Size	Gas	Size
BC Hydro	-	Telus	-	Shaw	-	FortisBC	-
Overhead Service		Overhead Service		Overhead Service			

Installed by:		Survey Date:	-
Comments:	Water service as per october 2016 locate		

**NOT TO SCALE The information contained herein is for internal use only.
Not to be relied on unless confirmed by site inspection and/or investigation.**

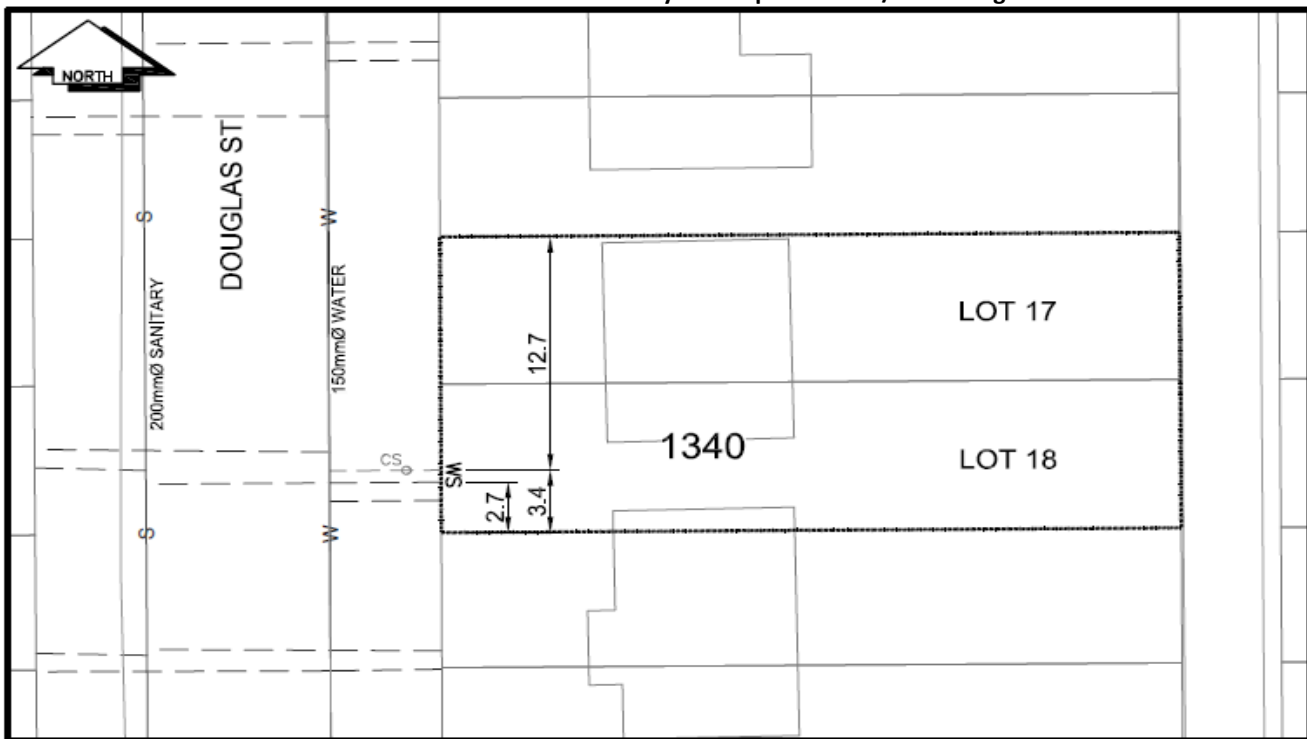

LEGEND:	
CS ^o	CURB STOP
CO ^o	CLEAN OUT
WV	WATER VALVE
W	WATER SERVICE
S	SANITARY SERVICE
FH	FIRE HYDRANT
SS	STORM SERVICE
G	GAS
---	ENCUMBRANCE

NOT TO SCALE