

City of Prince George HISTORY SHEET

SHEET NUMBER

Roll Number 00909519

Legal: LOT'S 30 BLOCK _____ D.L. 2507 PLAN 20259

Address: 4336 DOVE AVE.

Sanitary Connection: # 8109 SIZE 100mm MATERIAL A.C. INV. _____ CONNECTED

Water Connection # 8109 SIZE 20mm MATERIAL CU. METER _____ CONNECTED

Storm Connection: # _____ SIZE _____ MATERIAL _____ INV. _____ CONNECTED

Cash Receipt No's: WATER _____ SANITARY _____ STORM _____

CURB FROM PROPERTY LINE 4.377 m PAVEMENT WIDTH 10.363 m

B.C. HYDRO U/G UNDERGROUND CONNECTION



B.C. TELEPHONE U/G UNDERGROUND CONNECTION

INLAND GAS AS SHOWN

Information Sheets:

Comments:

**THE INFORMATION CONTAINED HEREIN IS FOR INTERNAL USE ONLY.
NOT TO BE RELIED UPON UNLESS CONFIRMED BY SITE INSPECTION AND/OR INVESTIGATION**

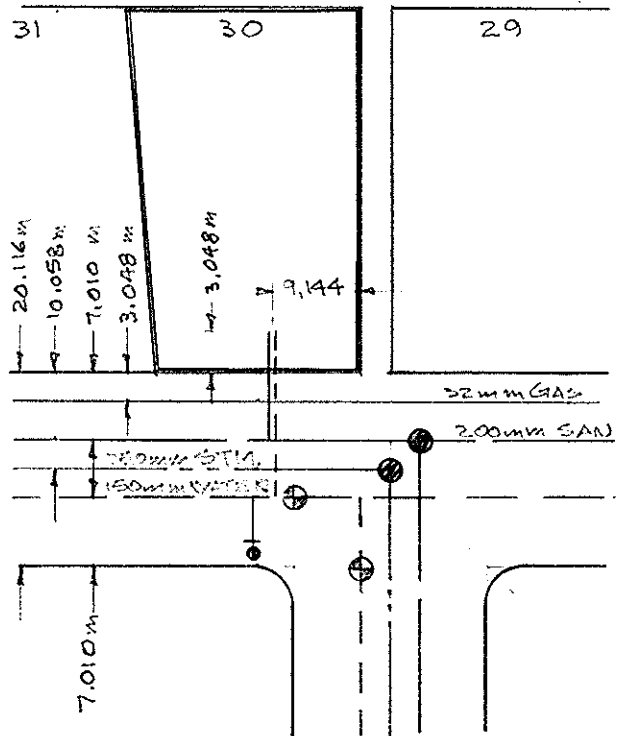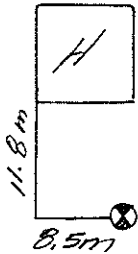

DOVE AVE.

BOYRON
CRESES.