



City of Prince George  
**History Sheet**

|      |             |
|------|-------------|
| PID: | 004701569   |
| MU:  | 101412      |
| WO:  | 72229/72230 |

Civic Address: 1171 Carney St

Legal Description: Lot: 4 Block: 4 District Lot: 1429 Plan: 646


| Service Type | Diameter (mm) | Material | Invert Elev at main (m) | Invert Elev at property line (m) | Invert Elev at service end (m) | Distance into property (m) | Installation Date |
|--------------|---------------|----------|-------------------------|----------------------------------|--------------------------------|----------------------------|-------------------|
| Sanitary     | 100mm         | PVC      | -                       | -                                | -                              | -                          | July 2013         |
| Water        | 20mm          | Copper   | -                       | -                                | -                              | -                          | July 2013         |
| Storm        | N/A           | N/A      | -                       | -                                | -                              | -                          |                   |

| Service Connection Location     |      |                         |      | Sanitary (m) | Storm (m) |
|---------------------------------|------|-------------------------|------|--------------|-----------|
| Distance from downstream San MH | 2830 | towards upstream San MH | 3068 | 37.90        |           |
| Distance from downstream Stm MH | -    | towards upstream Stm MH | -    |              |           |

| Power            | Size | Communications   | Size | Cable            | Size | Gas      | Size |
|------------------|------|------------------|------|------------------|------|----------|------|
| BC Hydro         | -    | Telus            | -    | Shaw             | -    | FortisBC | -    |
| Overhead Service |      | Overhead Service |      | Overhead Service |      |          |      |

|               |                              |              |   |
|---------------|------------------------------|--------------|---|
| Installed by: | City of Prince George forces | Survey Date: | - |
| Comments:     |                              |              |   |

**NOT TO SCALE** The information contained herein is for internal use only.  
Not to be relied on unless confirmed by site inspection and/or investigation.

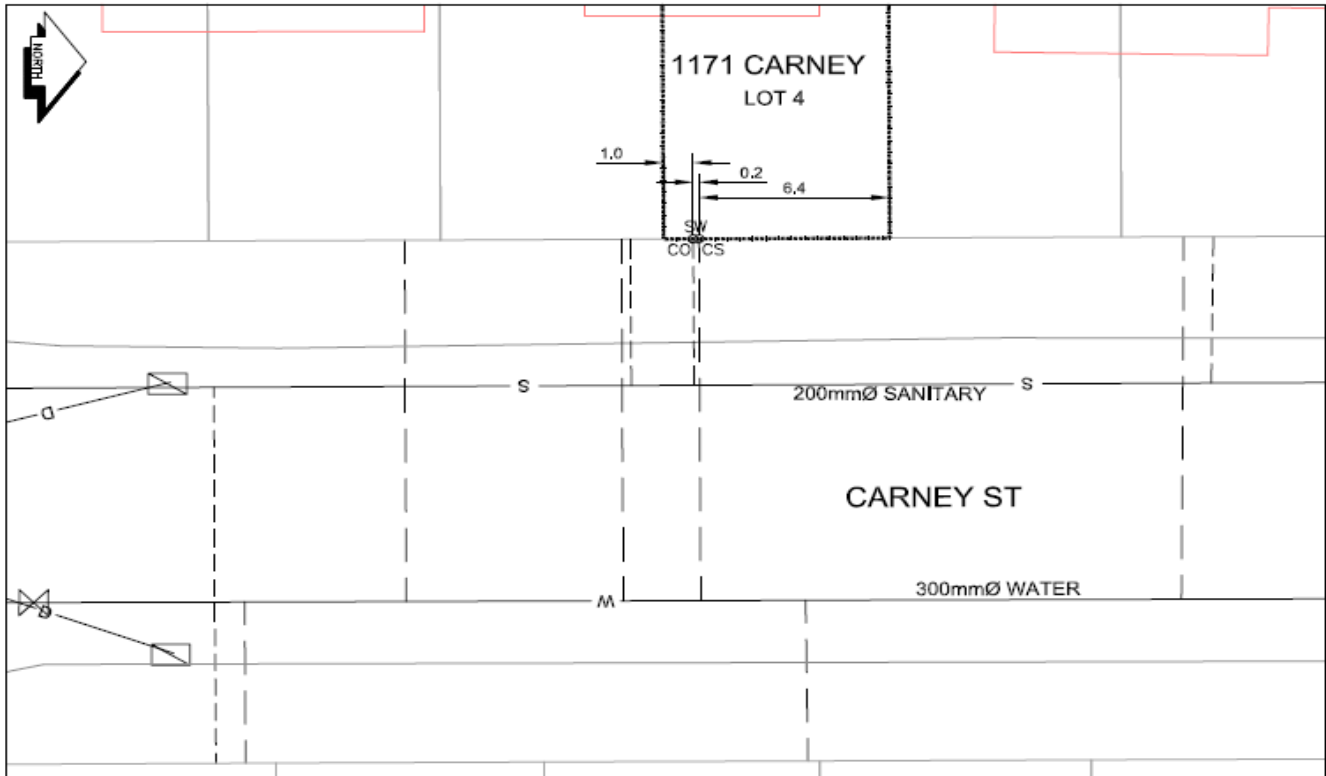

LEGEND:

|                 |           |     |                  |     |               |
|-----------------|-----------|-----|------------------|-----|---------------|
| CS <sup>o</sup> | CURB STOP | --- | WATER SERVICE    | --- | STORM SERVICE |
| CO <sup>o</sup> | CLEAN OUT | --- | SANITARY SERVICE | --- | WATER VALVE   |

**NOT TO SCALE**