



City of Prince George
History Sheet

PID:	004702824
PID:	004702808
WO:	

Civic Address: 1226 Douglas St

Legal Description: Lot: 15 - 16 Block: 3 District Lot: 1429 Plan: 646


Service Type	Diameter (mm)	Material	Invert Elev at main (m)	Invert Elev at property line (m)	Invert Elev at service end (m)	Distance into property (m)	Installation Date
Sanitary	100mm	PVC	586.86	2.19	587.97	-	April 1958
Water	20mm	Copper	-	-	-	-	October 1956
Storm	N/A	N/A	-	-	-	-	

Service Connection Location				Sanitary (m)	Storm (m)
Distance from downstream San MH	2831	towards upstream San MH	731	36.70	
Distance from downstream Stm MH	-	towards upstream Stm MH	-		

Power	Size	Communications	Size	Cable	Size	Gas	Size
BC Hydro	-	Telus	-	Shaw	-	FortisBC	-
Overhead Service		Overhead Service		Overhead Service			

Installed by:	City of Prince George forces	Survey Date:	-
Comments:	Water service location confirmed on March 19, 2013		

NOT TO SCALE The information contained herein is for internal use only.
Not to be relied on unless confirmed by site inspection and/or investigation.

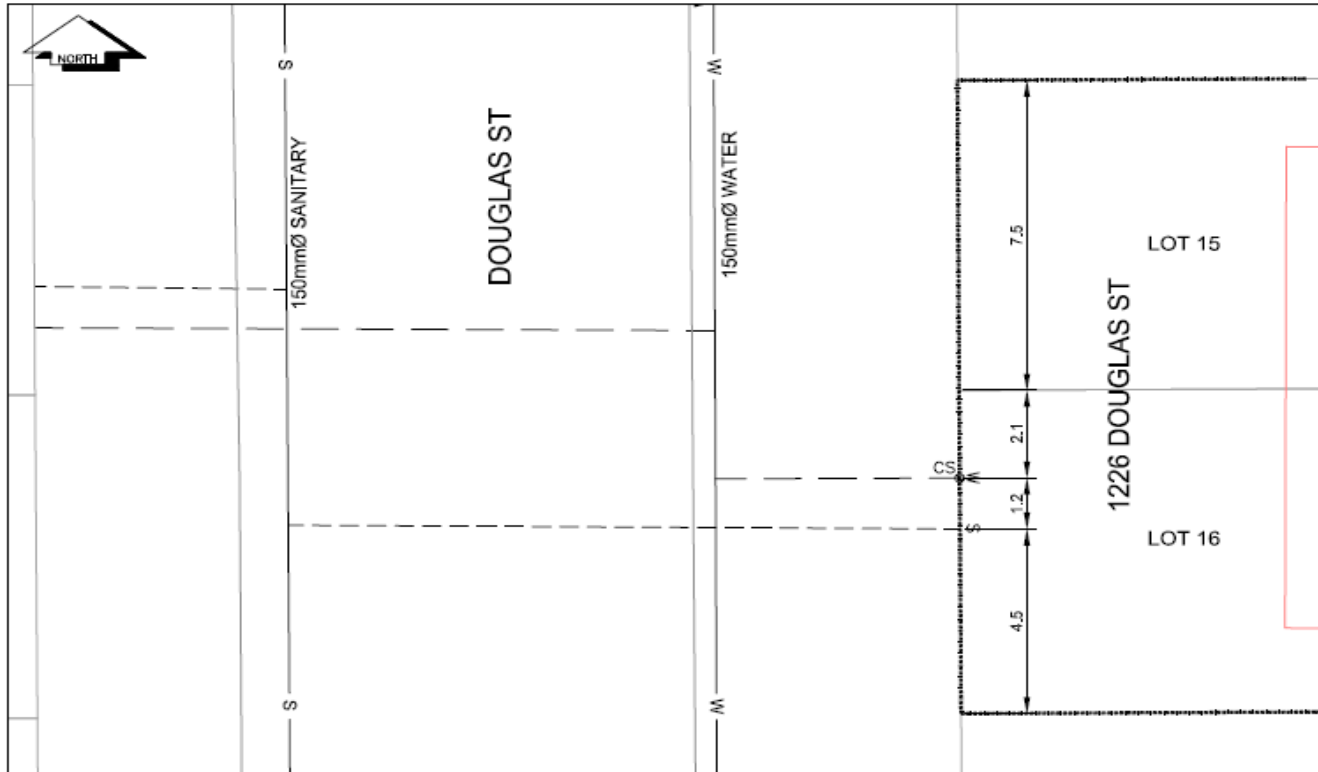

LEGEND: CS CURB STOP - - - - - W WATER SERVICE - - - - - S STORM SERVICE
CO CLEAN OUT - - - - - S SANITARY SERVICE X WATER VALVE

NOT TO SCALE