



City of Prince George

History Sheet

PID:	004704797
	004704801
SD/MU:	
WO:	

Civic Address: 1191 Carney Street

Legal Description: Lot: 1 Block: 4 District Lot: 1429 Plan: 646

Lot: 2 Block: 4 District Lot: 1429 Plan: 646


Service Type	Diameter (mm)	Material	Invert Elev at main (m)	Invert Elev at property line (m)	Invert Depth at service end (m)	Distance into property (m)	Installation Date
Sanitary	100mm	AC	585.81	587.84	1.68	-	September 1958
Water	20mm	Copper	-	-	-	-	July 2013
Storm	N/A	N/A	-	-	-	-	

Service Connection Location				Sanitary (m)	Storm (m)
Distance from downstream San MH	2830	towards upstream San MH	2831	23.37	
Distance from downstream Stm MH	-	towards upstream Stm MH	-		

Power	Size	Communications	Size	Cable	Size	Gas	Size
BC Hydro	-	Telus	-	Shaw	-	FortisBC	-
Overhead Service		Overhead Service		Overhead Service			

Installed by:	City of Prince George forces	Survey Date:	-
Comments:	Old water service was replaced in July 2013 as per John Handler.		

NOT TO SCALE The information contained herein is for internal use only.
Not to be relied on unless confirmed by site inspection and/or investigation.

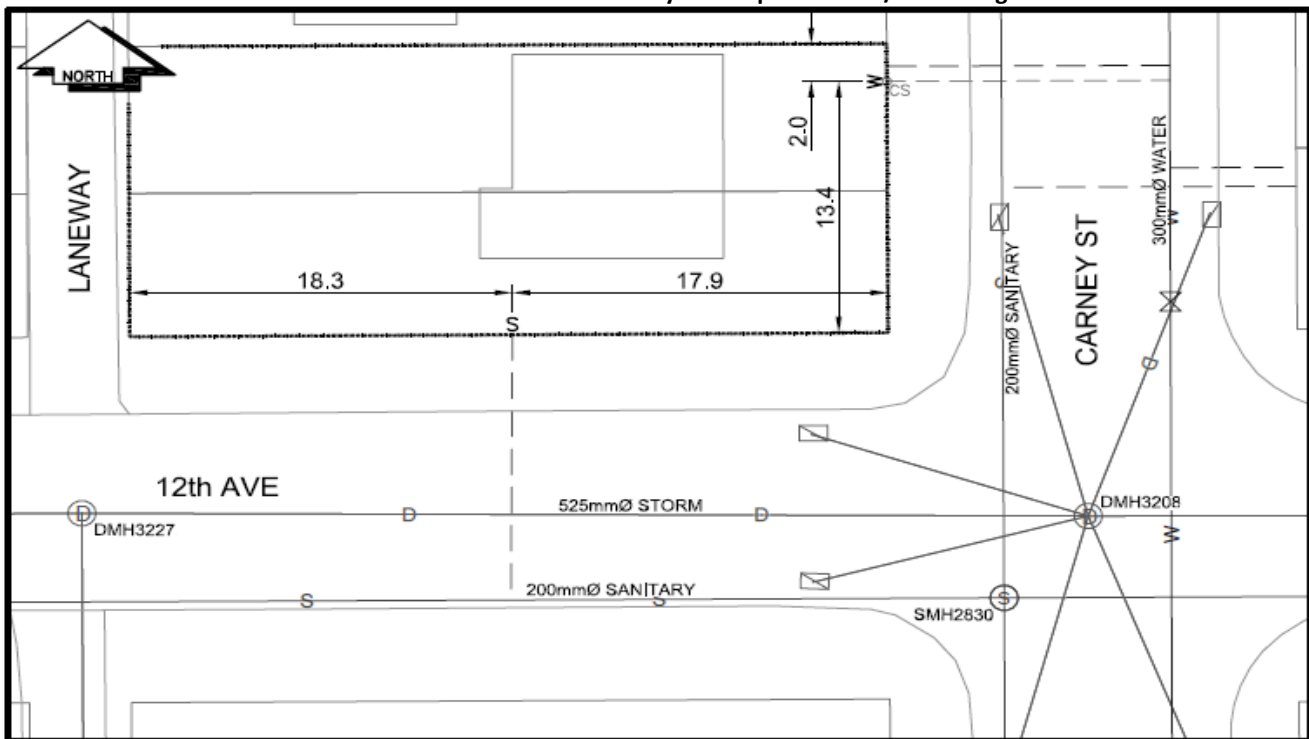

LEGEND:	
CS ^o	CURB STOP
CO ^o	CLEAN OUT
⊗	WATER VALVE
---	WATER SERVICE
---	SANITARY SERVICE
⊗	FIRE HYDRANT
---	STORM SERVICE
---	GAS
---	ENCUMBRANCE

NOT TO SCALE